
#1473

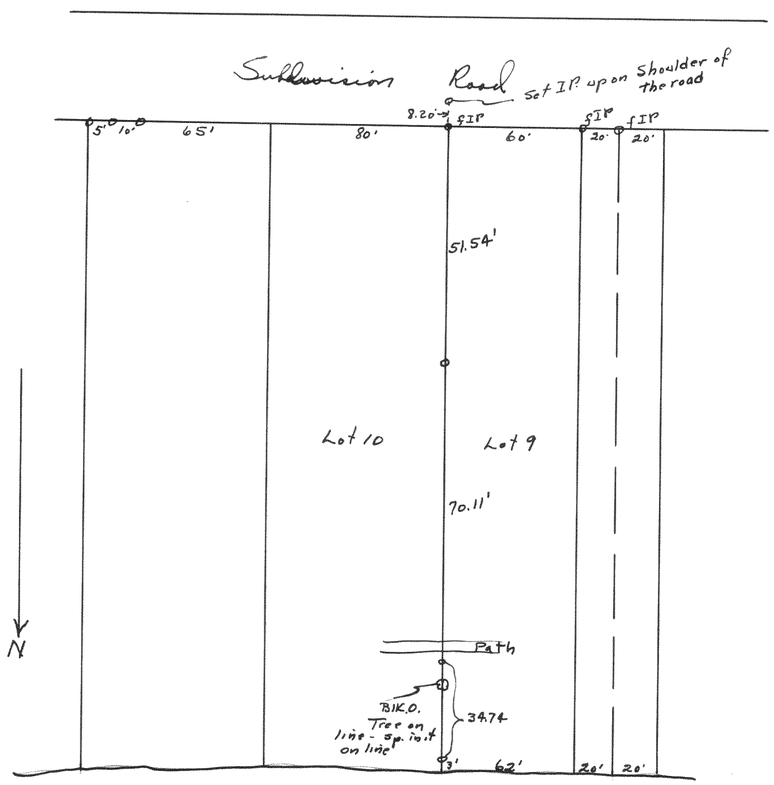


Geneva Lake

Plat of survey of the East line of Lot 9 of Blk. 1 of Woodale Add. located in fractional Section 9, T1N R17E of Walworth County Wisconsin.

Sept. 1944

Lloyd L. Jensen
County Surveyor

#1474

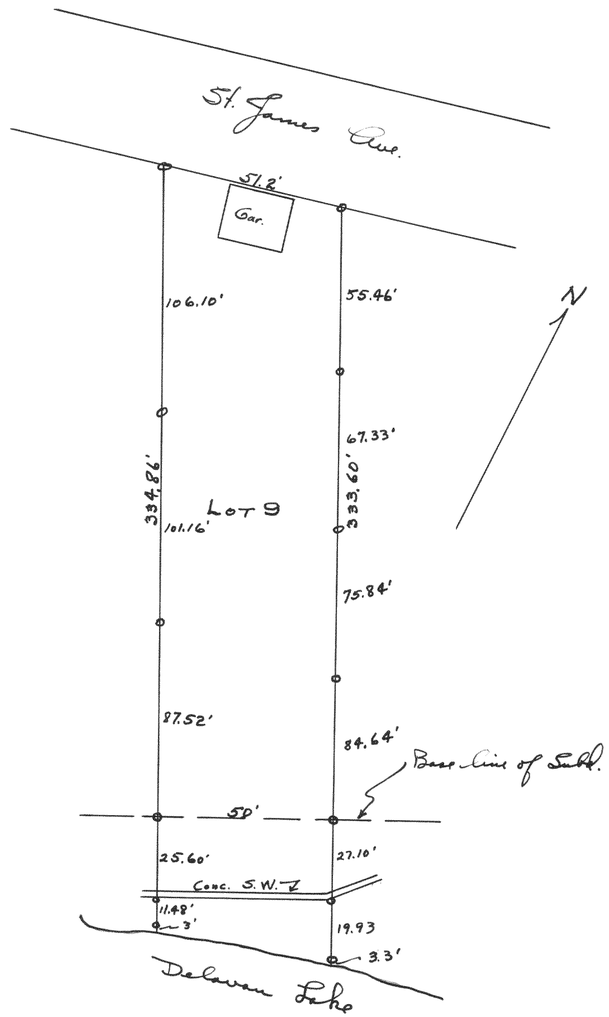

Plat of survey of Lot 9 of St. Mary's Subdivision located in Section 28, T2N R16E.

Nov. 1944

Lloyd L. Jensen
County Surveyor