
#1475

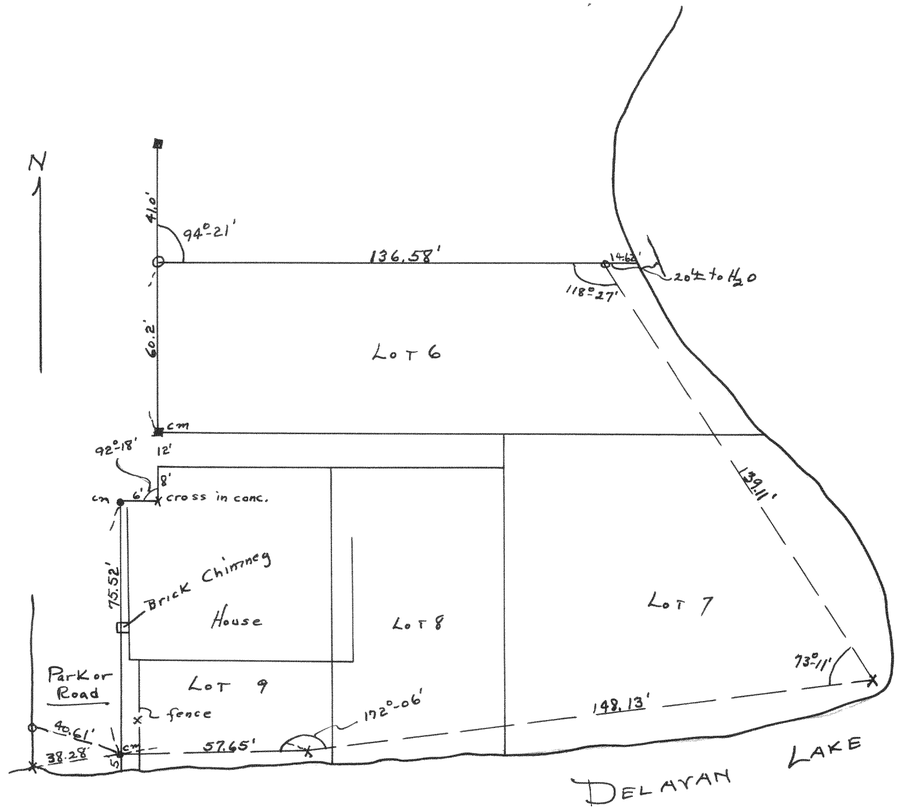


Plat of survey of Lots 6, 7, 8 and 9 of Willow Point Park Addition, located in Section 29, T2N R16E of Walworth County Wisconsin.

Sept. 1944

Floyd L. Jensen
County Surveyor

#1476

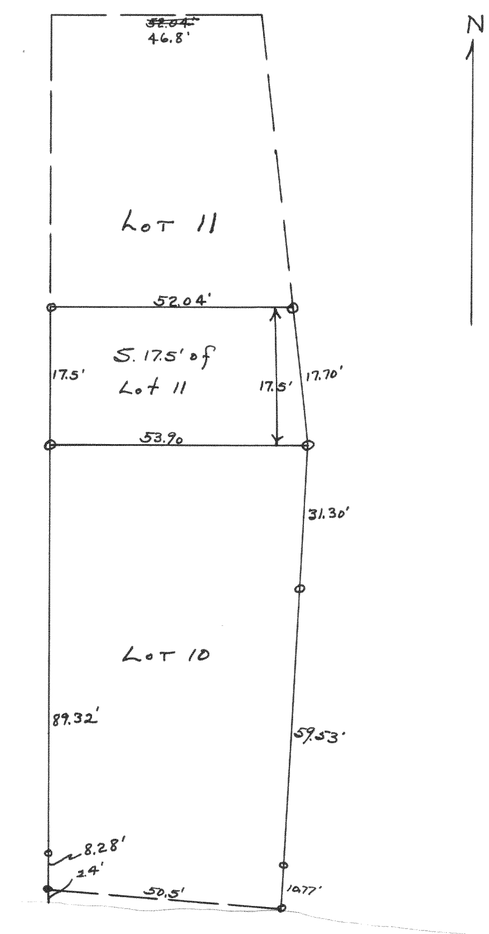

Plat of survey of Lot 10 and the South 17.50 feet of Lot 11 of Willow Point Park Add, Section 29, T2N R16E, Walworth County Wisconsin.

Aug. 1944

Floyd L. Jensen
County Surveyor