
#1479

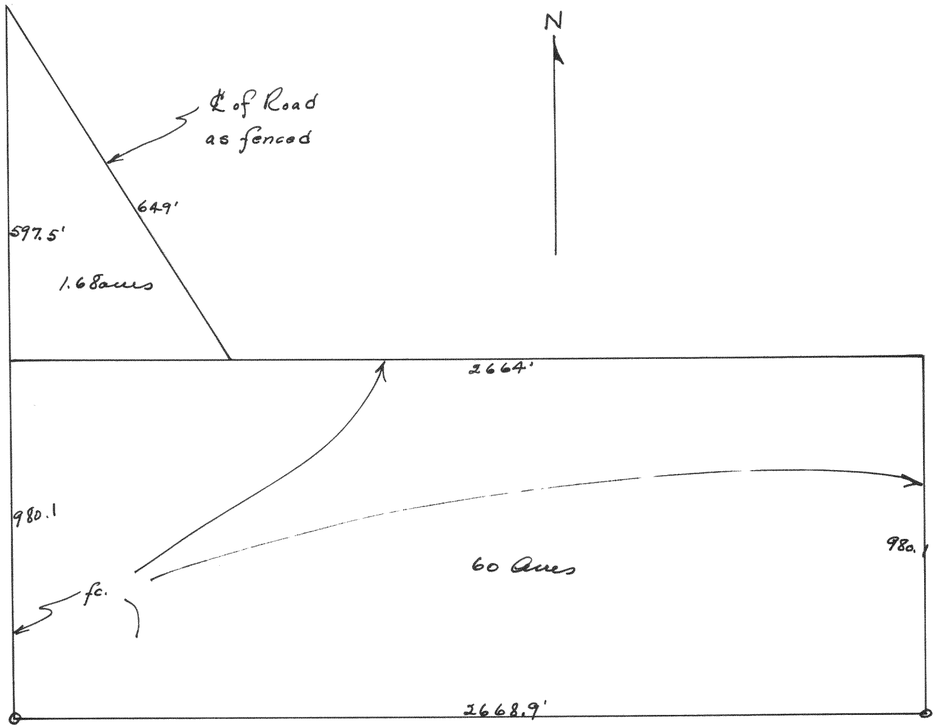


Plat of a survey using the existing fences to lay out the North 60 acres of the South ½ of the SE¼ of Section 5, T27N R16E of Walworth County Wisconsin.

Aug. 1944

Lloyd L. Jensen
County Surveyor

#1480

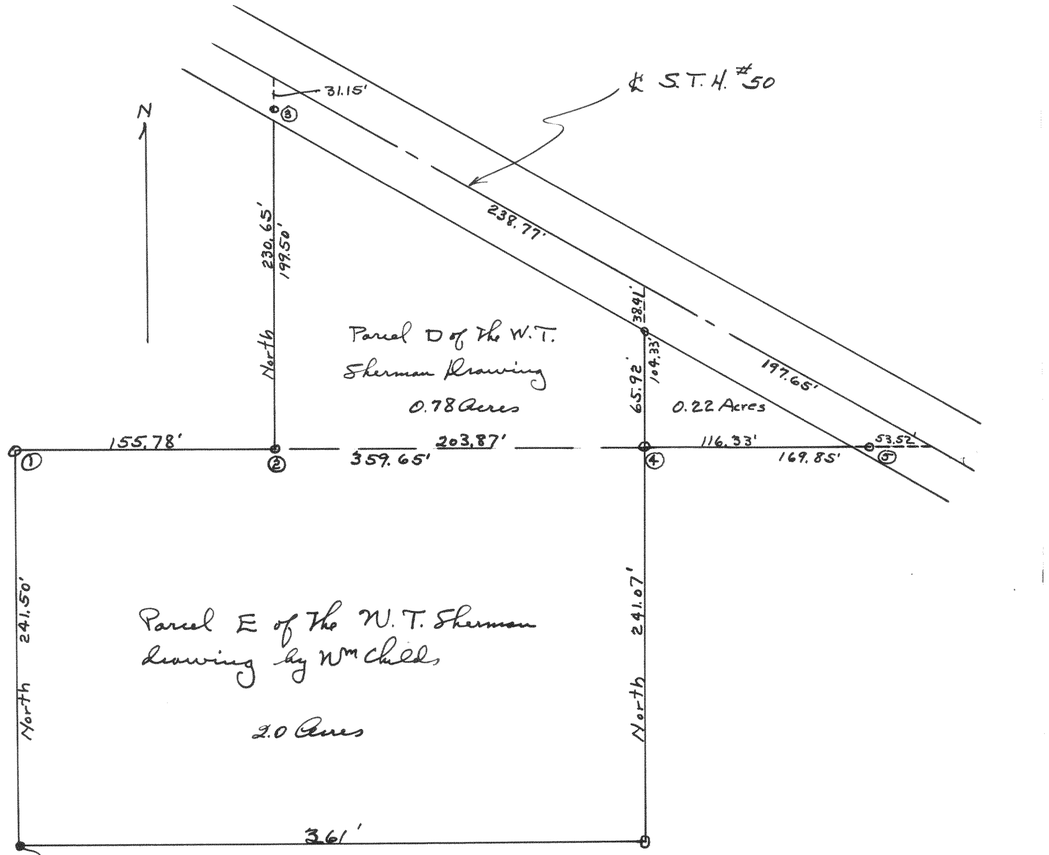

Plat of survey of land located in the SE¼ of Section 23, T27N R16E of Wal. Co. Wis. Iron pipes or pins were found at points numbered 1, 2, 3, 4, 5 & 6.

July 1944

Lloyd L. Jensen
County Surveyor