
#1481

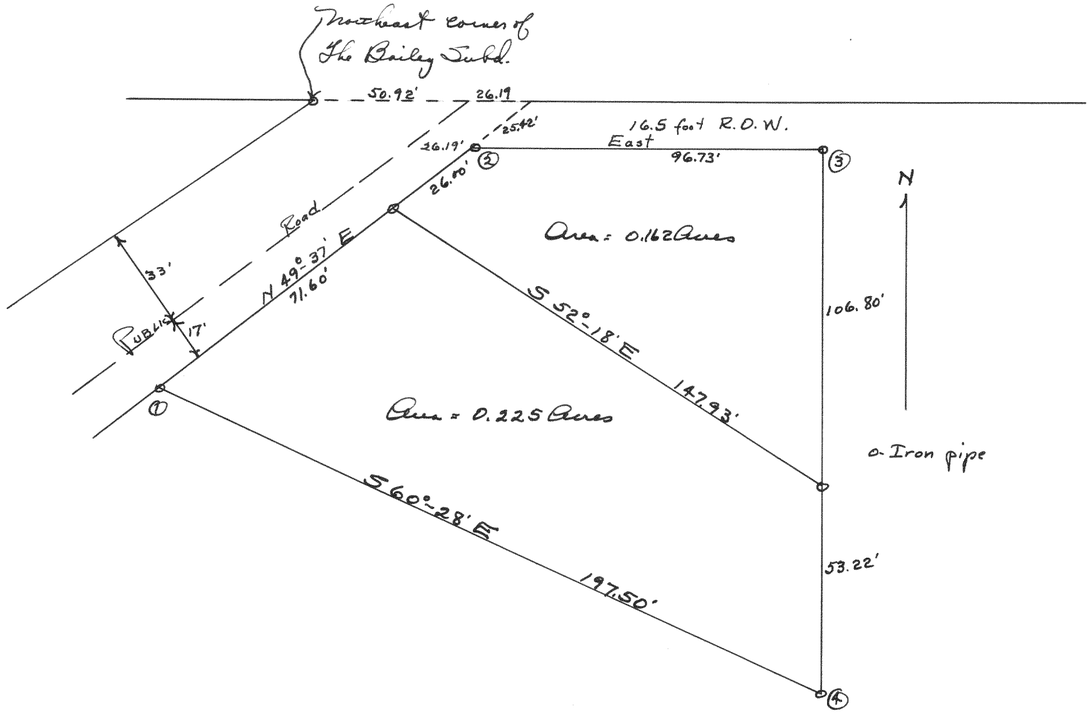



Plat of survey of land located in the West fractional ½ of Section 27, T2N R16E of Walworth County Wisconsin.
Iron pipes were found at points numbered ①, ②, ③ and ④.

July 1944

Lloyd L. Jensen
County Surveyor

#1482

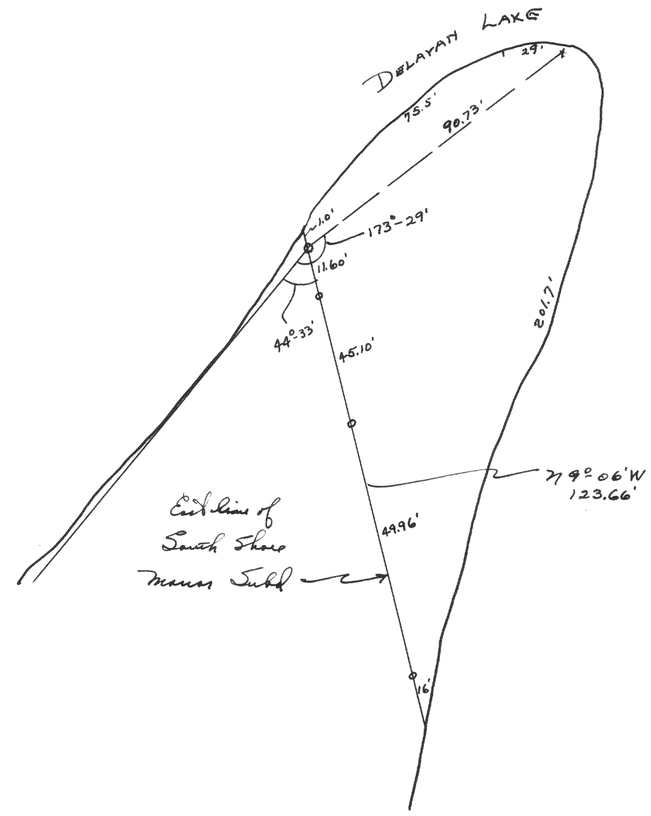


Plat of survey of a parcel of land lying just East of South shore Manor Subd. on the Tip of the point.

June 1944

Lloyd L. Jensen
County Surveyor