

SURVEY No. 1215

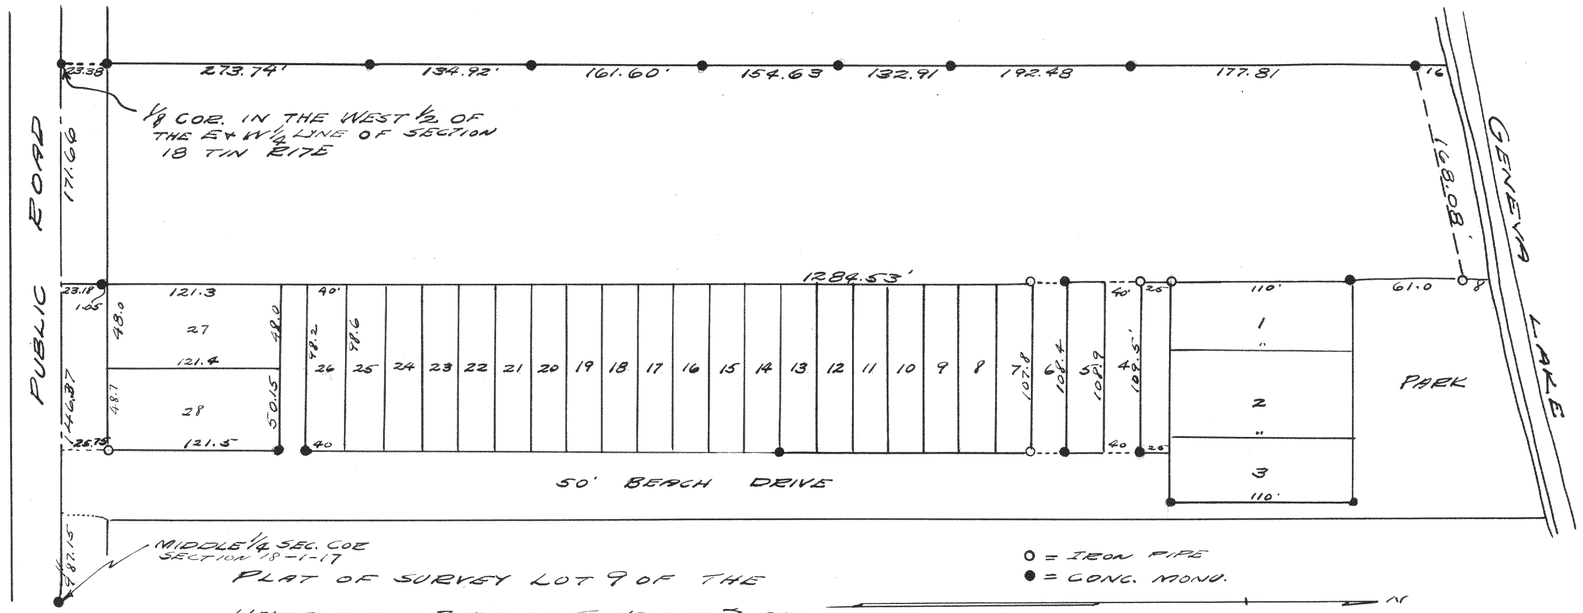

OCT. 1941

Lloyd L. Jensen
R.E.S.

SURVEY NO. 1216

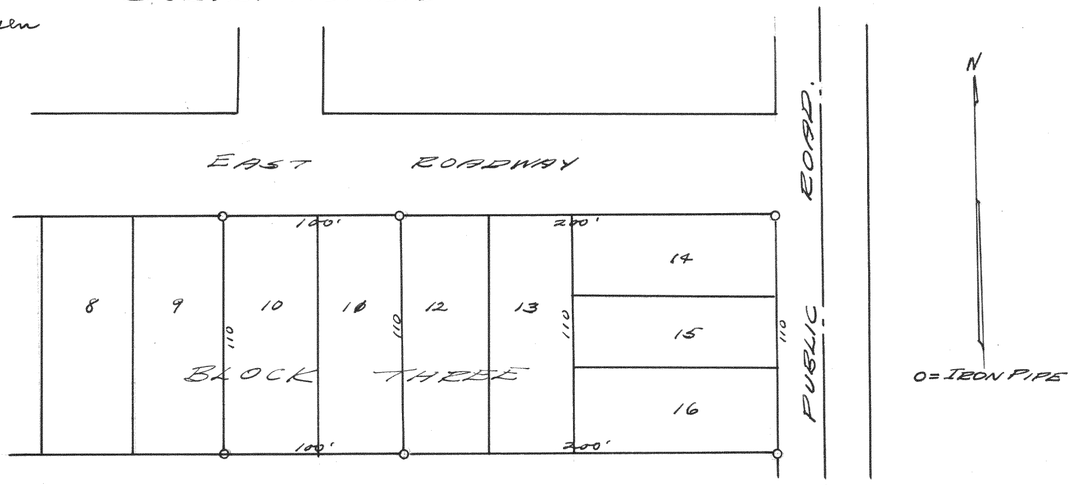

PLAT OF SURVEY OF LOTS 10 & 11 OF BLOCK 3 OF SUNSET HILLS SUBDIVISION, WHICH SUBDIVISION IS LOCATED IN SECTION 4 T1N R17E OF WALWORTH CO.
JULY 22, 1941

Lloyd L. Jensen
R.E.S.