
#1483

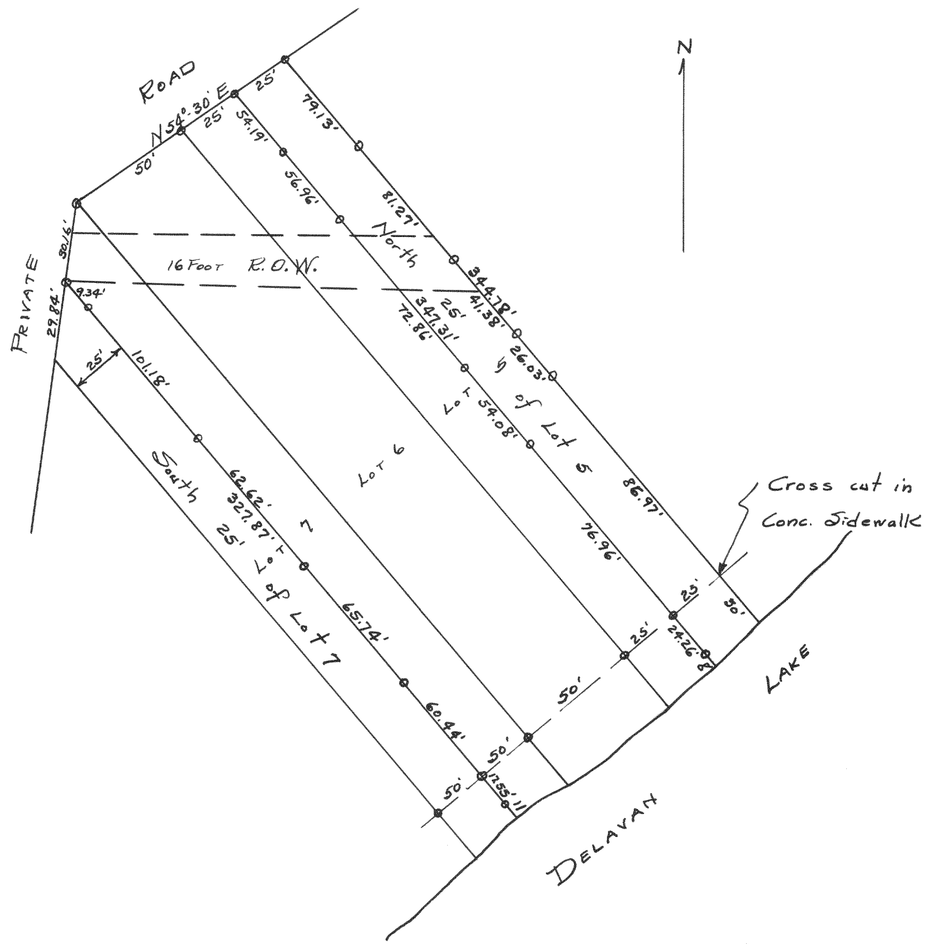


Plat of survey of lot lines in Willow Point Park Subdivision, located in Section 29, T2N R16E of Walworth County Wisconsin.

June 1944

Lloyd L. Jensen
County Surveyor

#1484

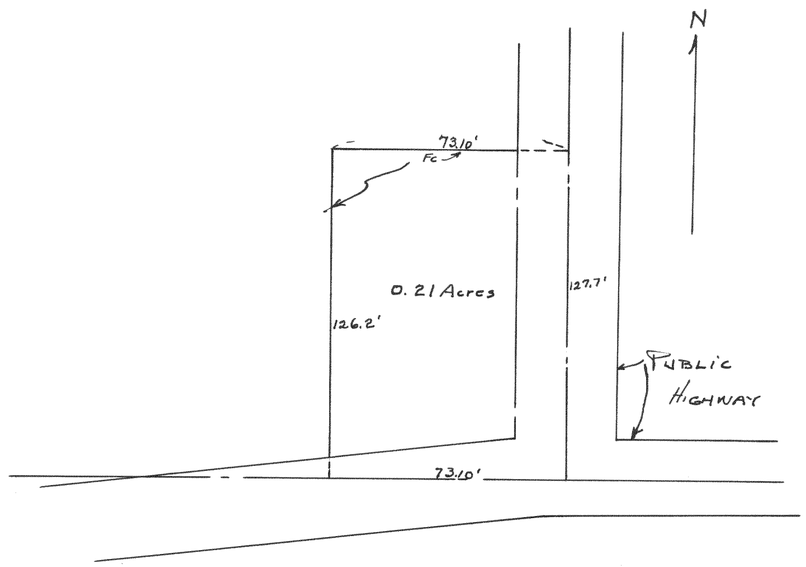

Plat of survey of a home lot located in the NW¼ of the NE¼ of Section 34, T3N R16E, used fences for line & ℄ of highway fences.

July 1944

Lloyd L. Jensen
County Surveyor