
#1491

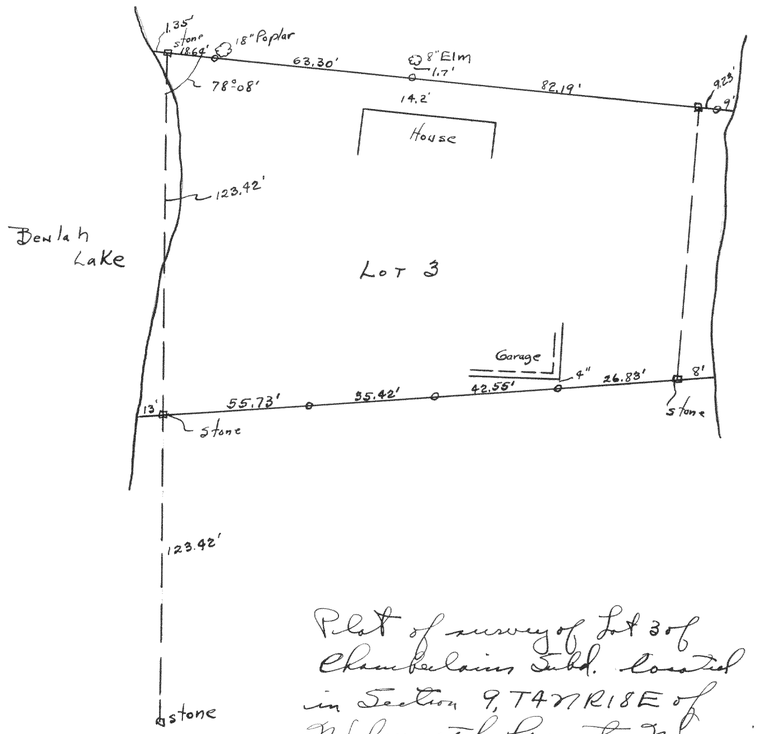


Plat of survey of Lot 3 of Chamberlains Subd. located in Section 9, T4N R18E of Walworth County Wisconsin

July 8, 1944

Lloyd L Jensen
County Surveyor

#1492

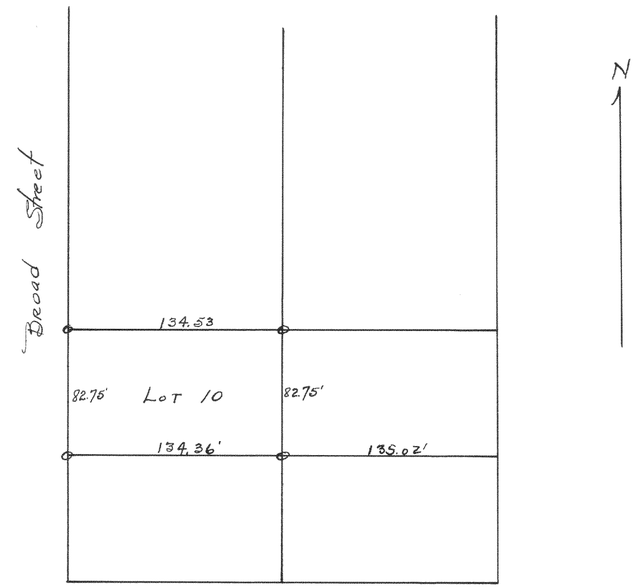

Jefferson Street

Plat of survey of Lot 10 of Blk. 9 of the original Plat of City of Elkhorn.

March 1944

Lloyd L Jensen
County Surveyor