
#1493

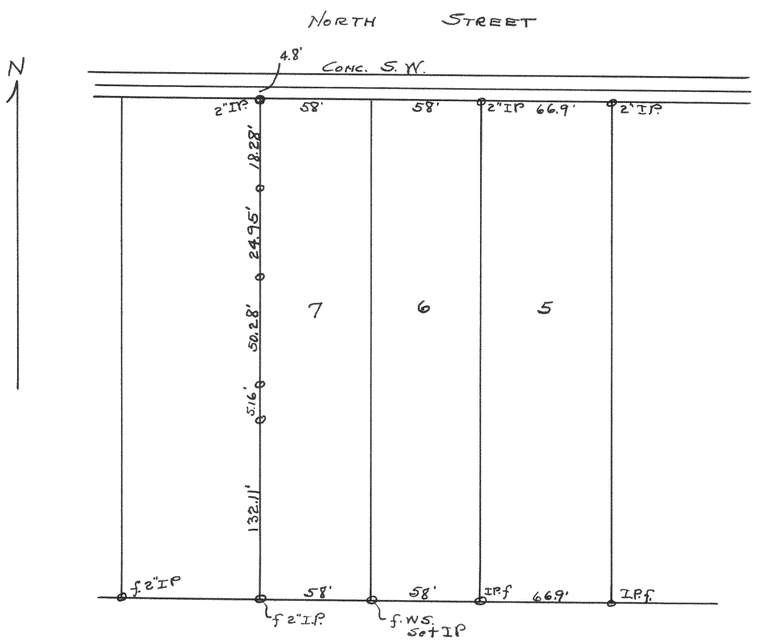


Plat of survey of the West line of Lot 7 of Fair View Subd., located in the City of Elkhorn, Walworth County Wis.

July 13, 1944

Floyd L. Jensen
County Surveyor

#1494

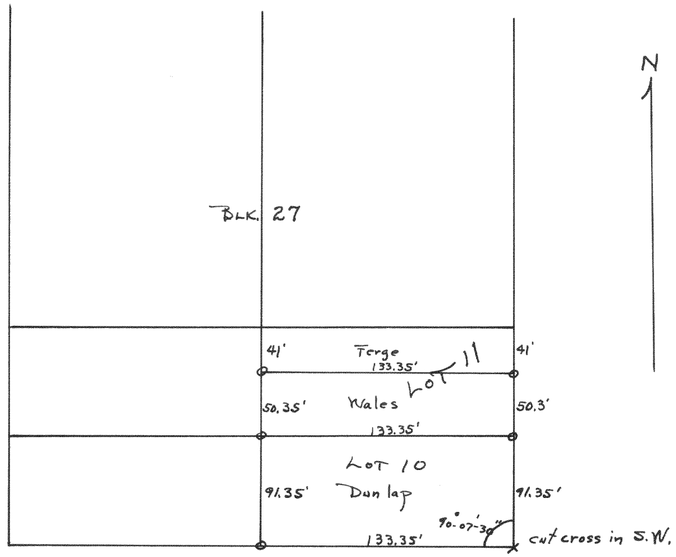

Plat of survey of Lot 10 and part of Lot 11 of Blk. 27 of the Original plat of the City of Elkhorn.

June 14, 1944

Floyd L. Jensen
County Surveyor