
#1495

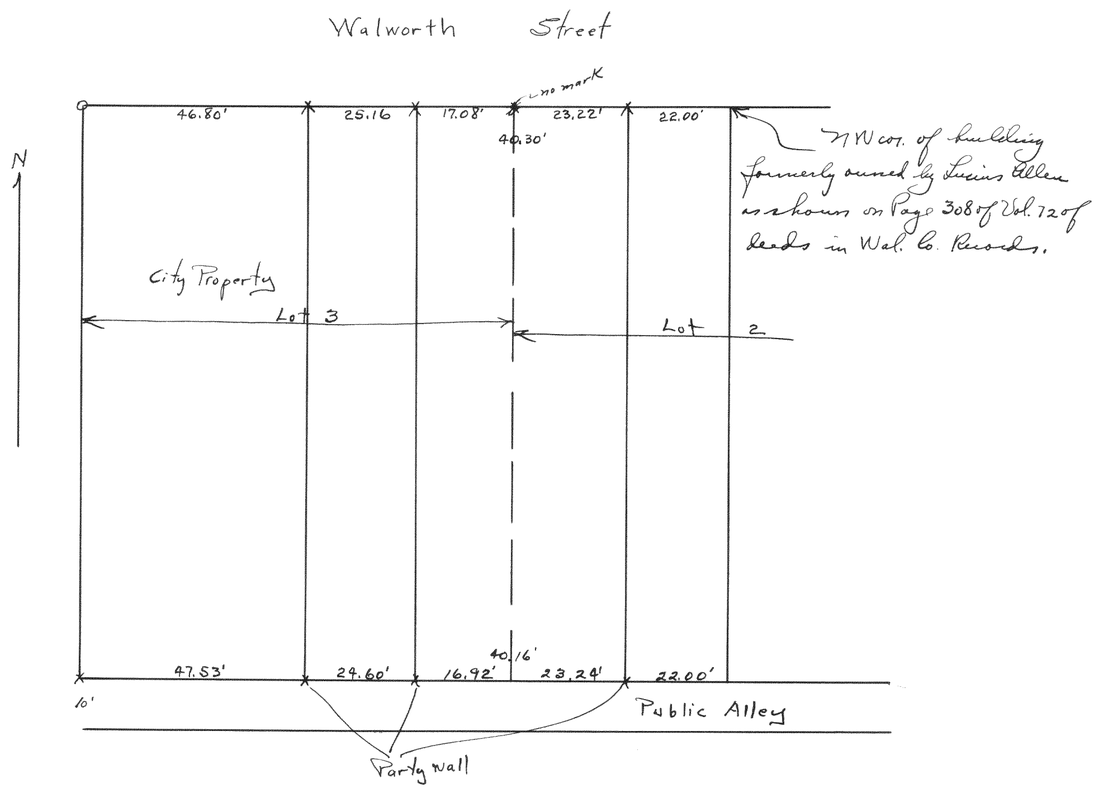


Plat of survey of part of Lt 2 and 3 of Blk. 26 of the Original plat of City of Elkhorn, Wal. Co. Wisconsin.

March 1944

Lloyd L. Jensen
County Surveyor

#1496

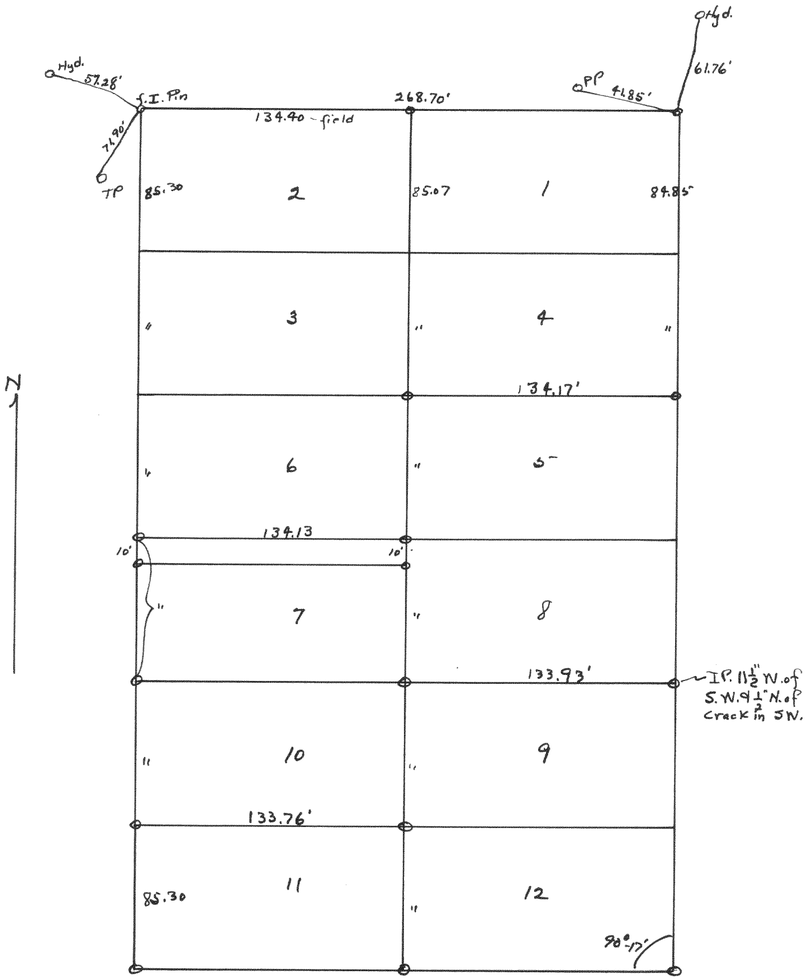

Plat of survey of Lots 5, 8, 7 and 10 of Blk. 39 of Hawes Addition to the City of Elkhorn.

April 19, 1944

Lloyd L. Jensen
County Surveyor