
#1497

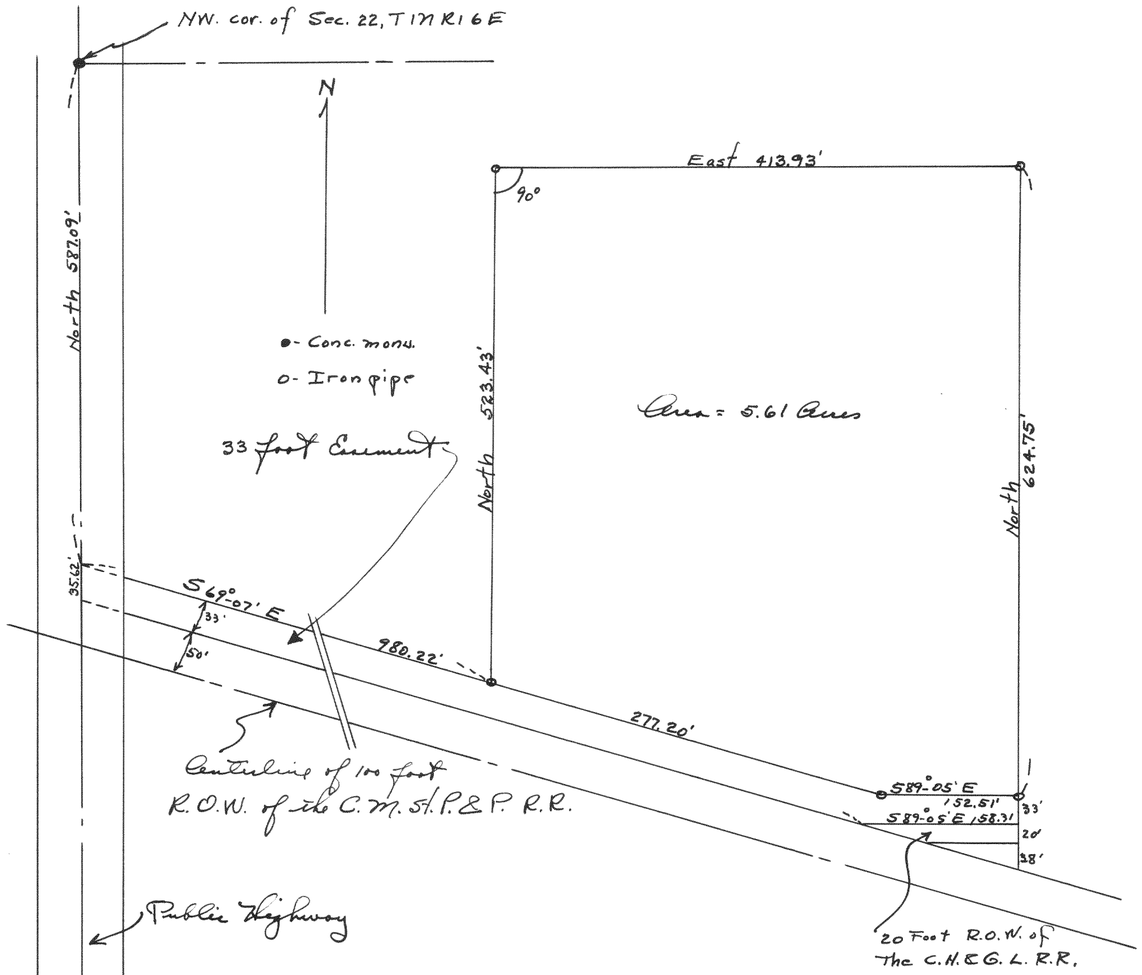


Plat of a survey of the old Hammer Mill factory at Walworth Village, Walworth County Wisconsin.

March 17, 1944

Floyd L. Jensen
County Surveyor

#1498

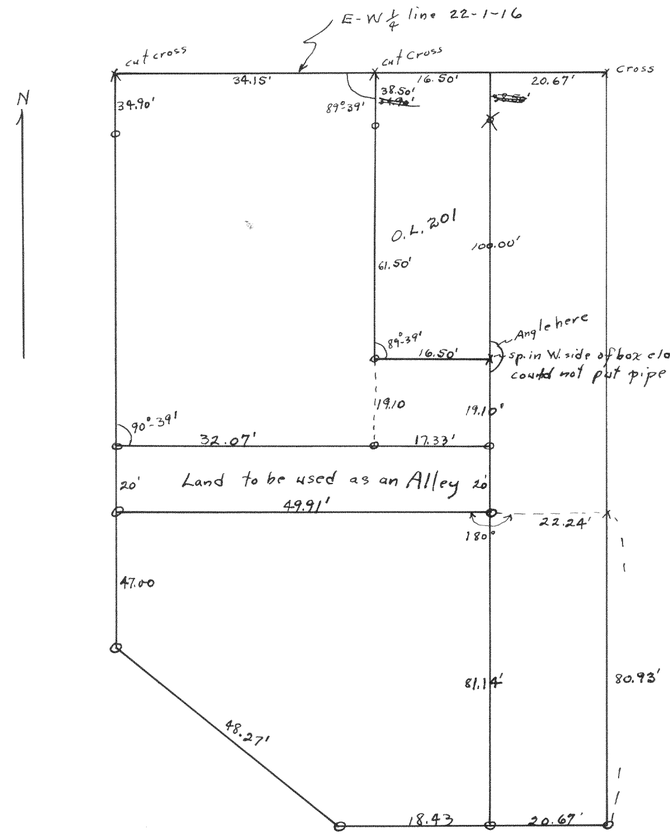

Plat of survey of part of O.L. #200 of the Assessor's Plat to the Village of ~~Fort~~ Walworth.

June 24, 1944

Floyd L. Jensen
County Surveyor