
#1499

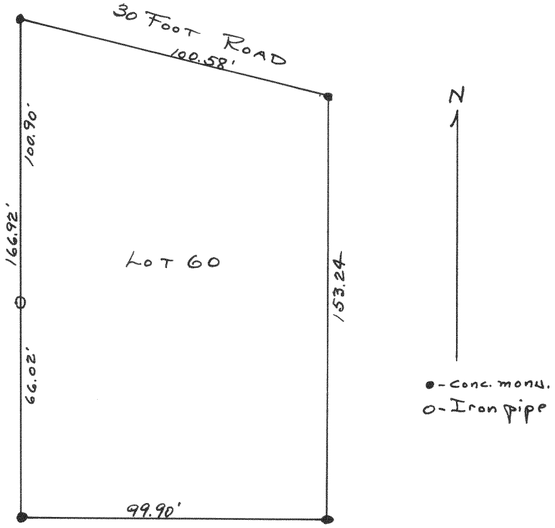


Plat of survey of Lot 60 of Unit No. 2 of Country Club Estates, located in Fontana Wisconsin.

Aug. 8, 1944

Lloyd D. Jensen
County Surveyor

#1500

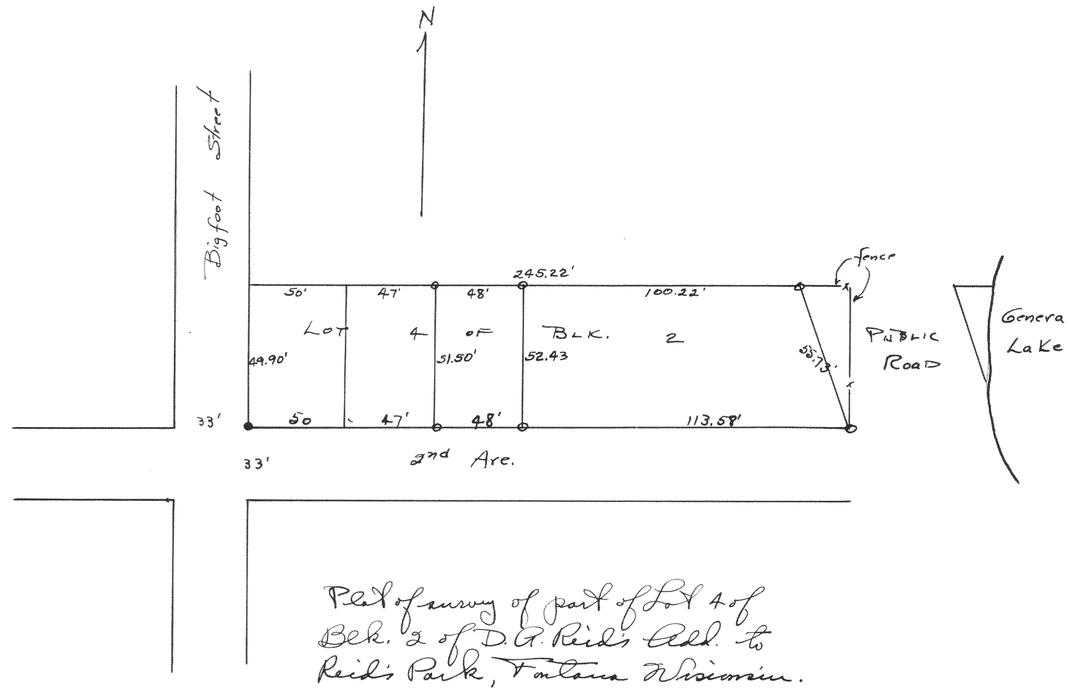

Plat of survey of part of Lot 4 of Blk. 2 of D.G. Reid's Add. to Reid's Park, Fontana Wisconsin.

June 16, 1944

Lloyd D. Jensen
County Surveyor