
#1501

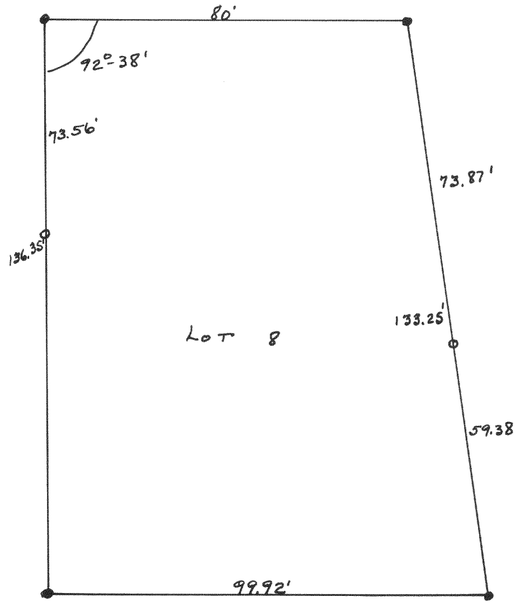


Plat of survey of Lot 8 of Blk. D of Unit 3 of Country Club Estates, located in the Village of Fontana.

June 18, 1944

Floyd L. Jensen
County Surveyor

#1502

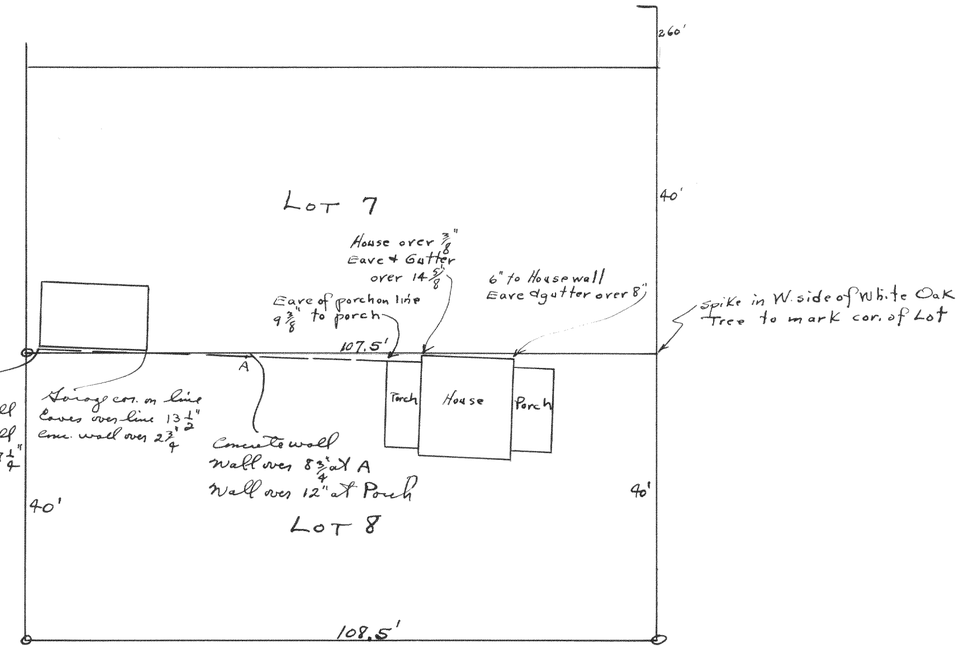

Plat of survey of the line between Lot 7 and 8 of Blk. 4 of D.G. Reid's Addition to Reid's Park, located in Fontana Wisconsin.

April 1944

Floyd L. Jensen
County Surveyor