
#1505

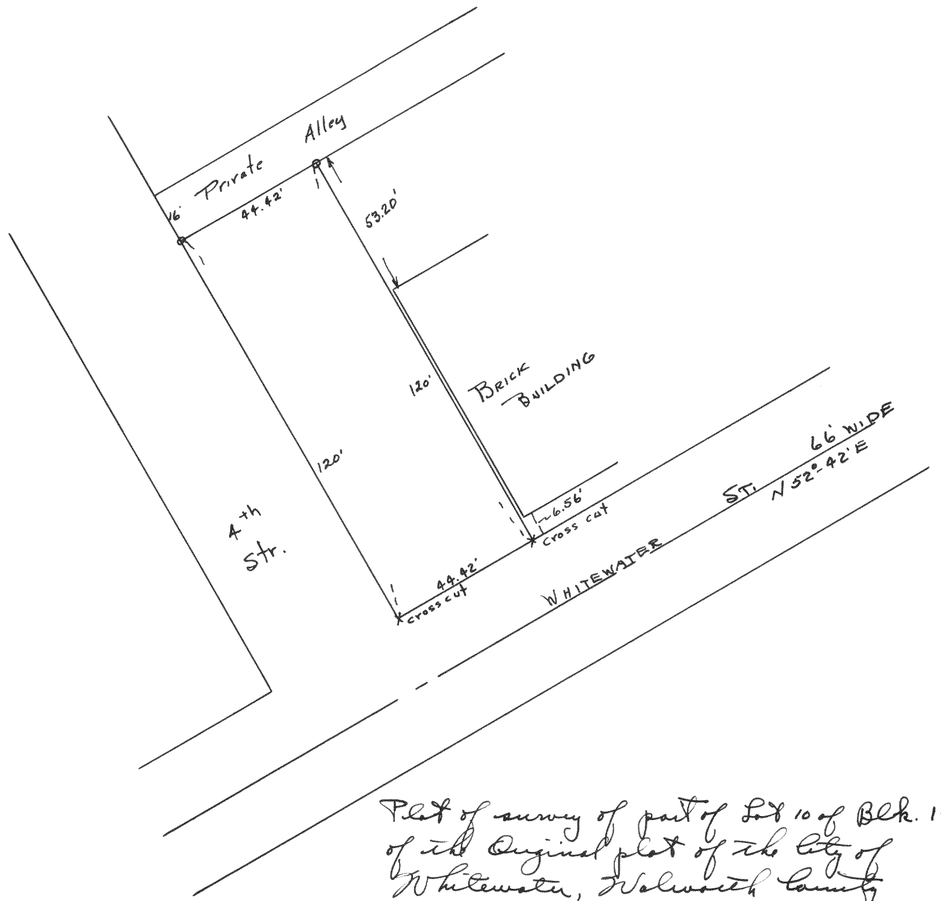



Plat of survey of part of Lot 10 of Blk. 14 of the Original plat of the City of Whitewater, Walworth County Wisconsin.

March 21, 1944

Floyd S. Jensen
County Surveyor

#1506

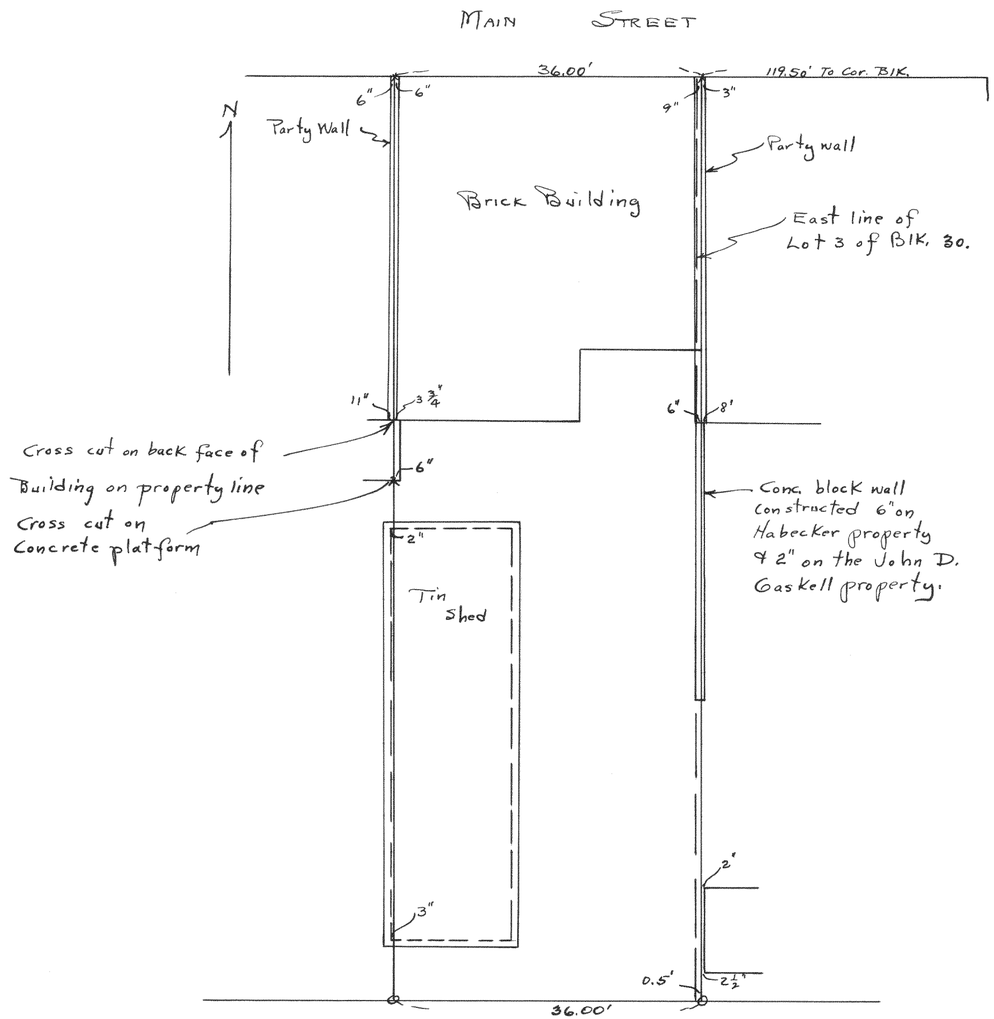


Plat of survey of part of Lots 2 and 3 of Block 30 of the Original Plat of the City of Lake Geneva, Walworth County Wisconsin.

Sept. 1944

Floyd S. Jensen
County Surveyor