
#1507

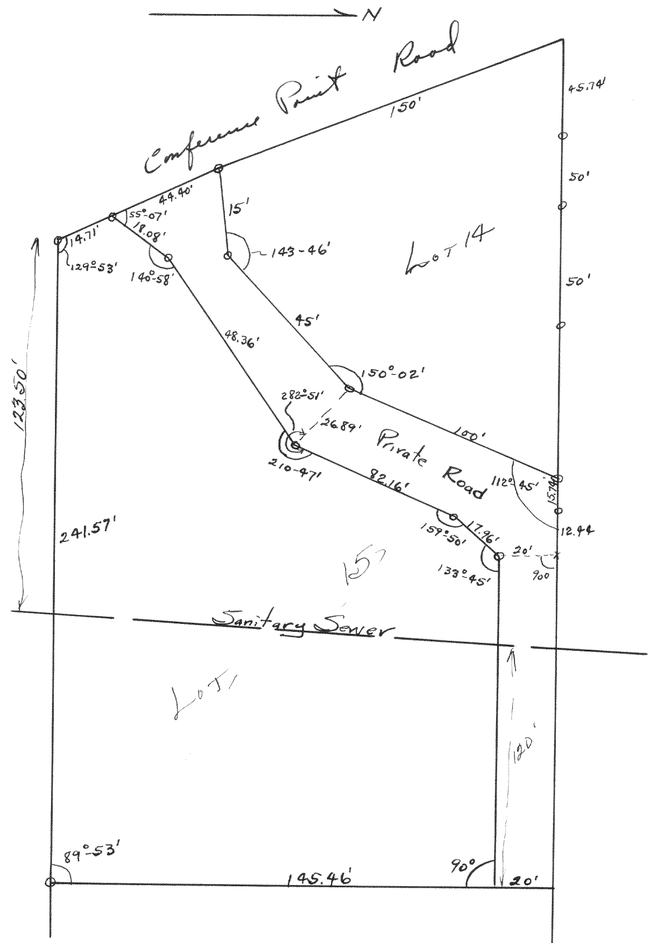


Plat of survey of part of Lot 15 of Jewell's Subdivision, located in The Village of Williams Bay Wisconsin.

July 11, 1944

Lloyd A. Jensen
County Surveyor

#1508

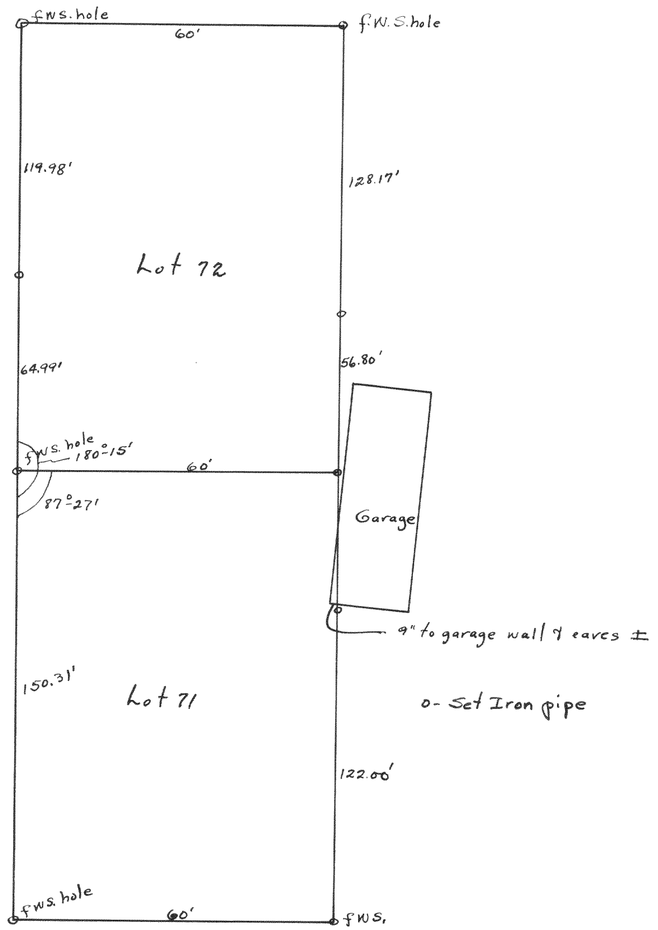

Plat of survey of Lots 71 & 72 of Bay View Subdivision located in the Village of Williams Bay Wisconsin.

June 29, 1944

Lloyd A. Jensen
County Surveyor