
#1509

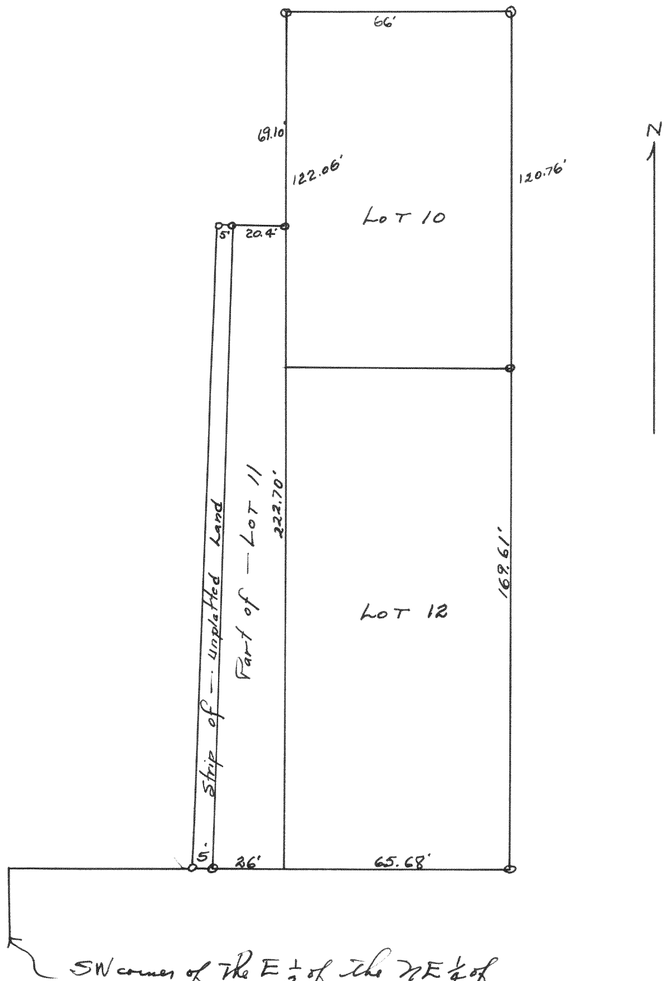


SW corner of the E½ of the NE¼ of Fractional Section 1, T1NR16E

Plat of a survey of Lots 10, 12, part of 11 of Johnson's Addition to the Village of Williams Bay and a 5 foot strip lying West of part of Lot 11.

May 1944

Lloyd L. Jensen
County Surveyor

#1510

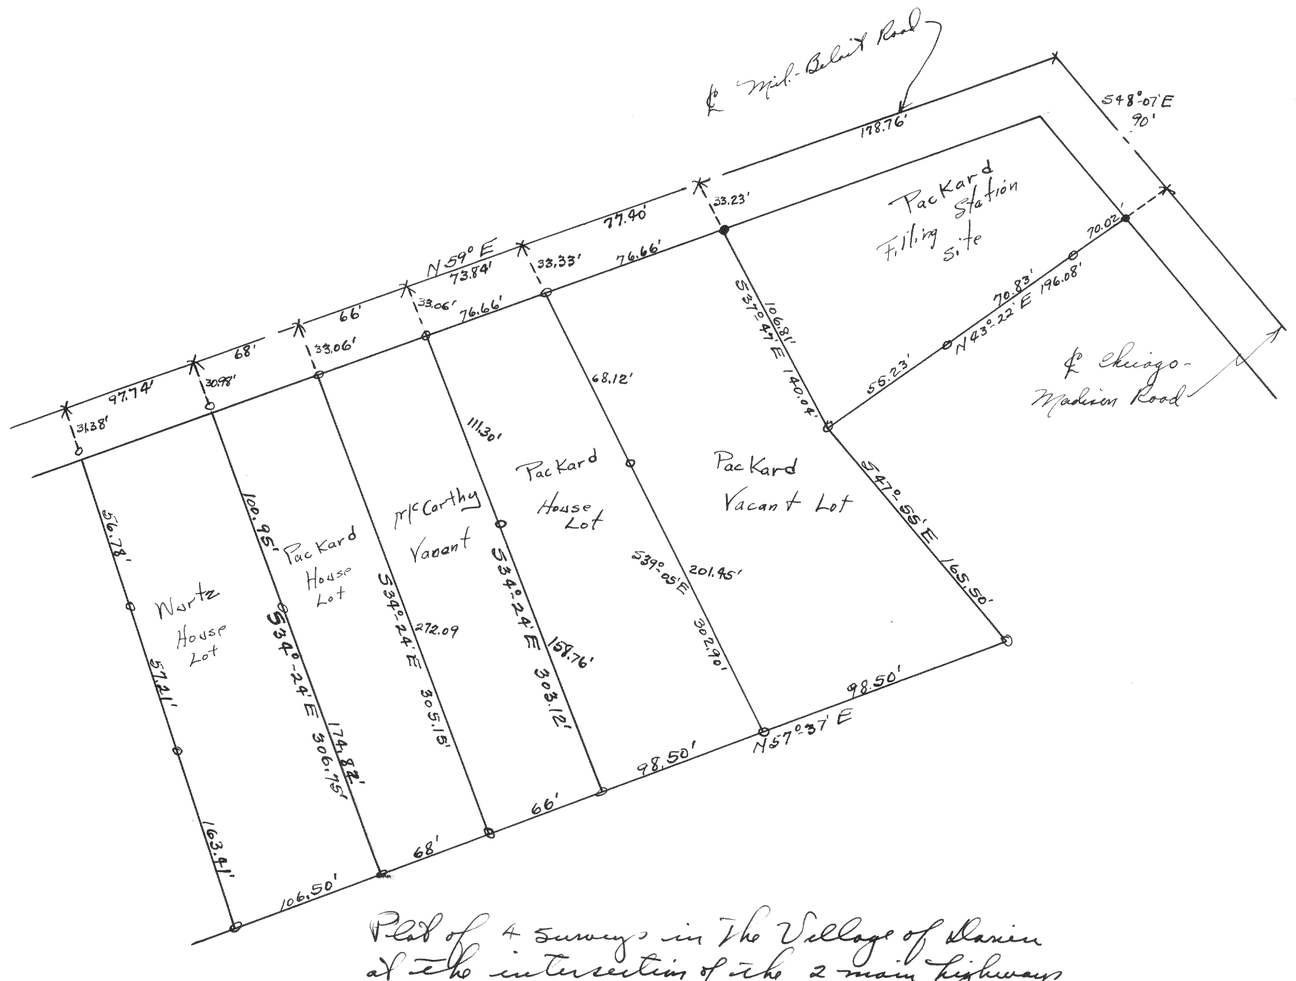


July 1944

Lloyd L. Jensen
County Surveyor