#1510

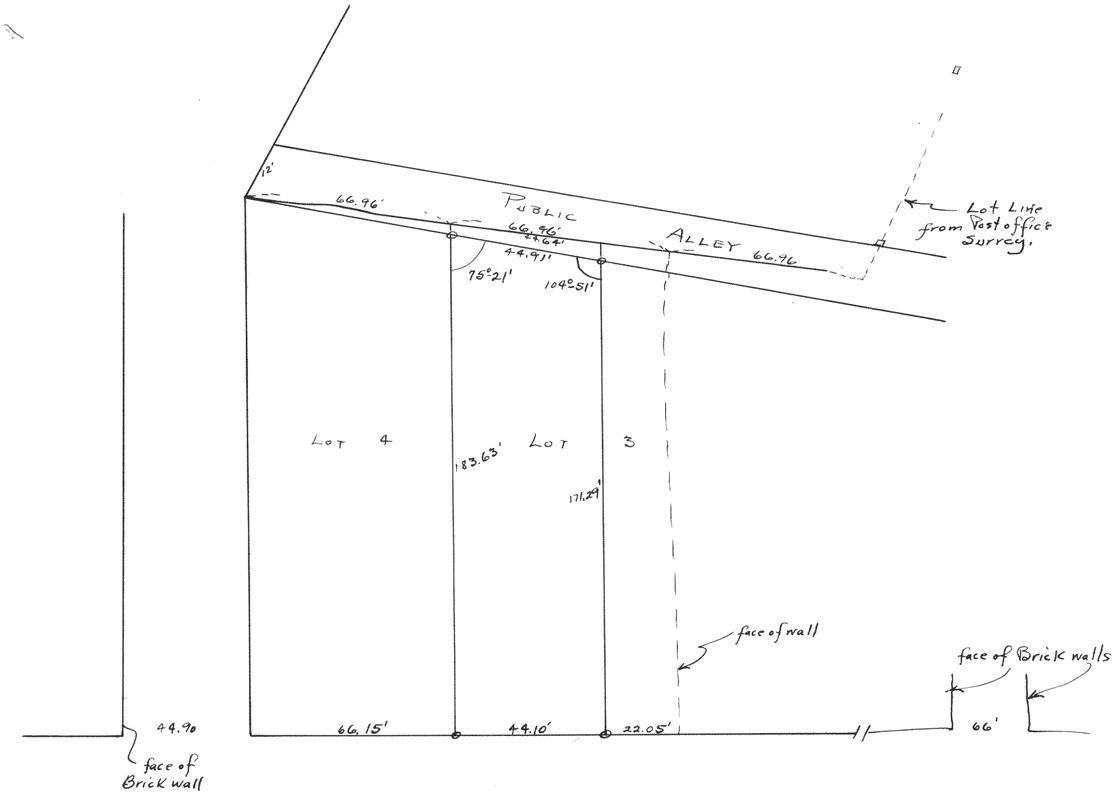

Plat of survey of the West 2 of Lt 3 of Blk. 14 of the Original plat of the City of Whitewater, Walworth County Wisconsin.

March 1944

Lloyd L. Jensen
County Surveyor

#1511

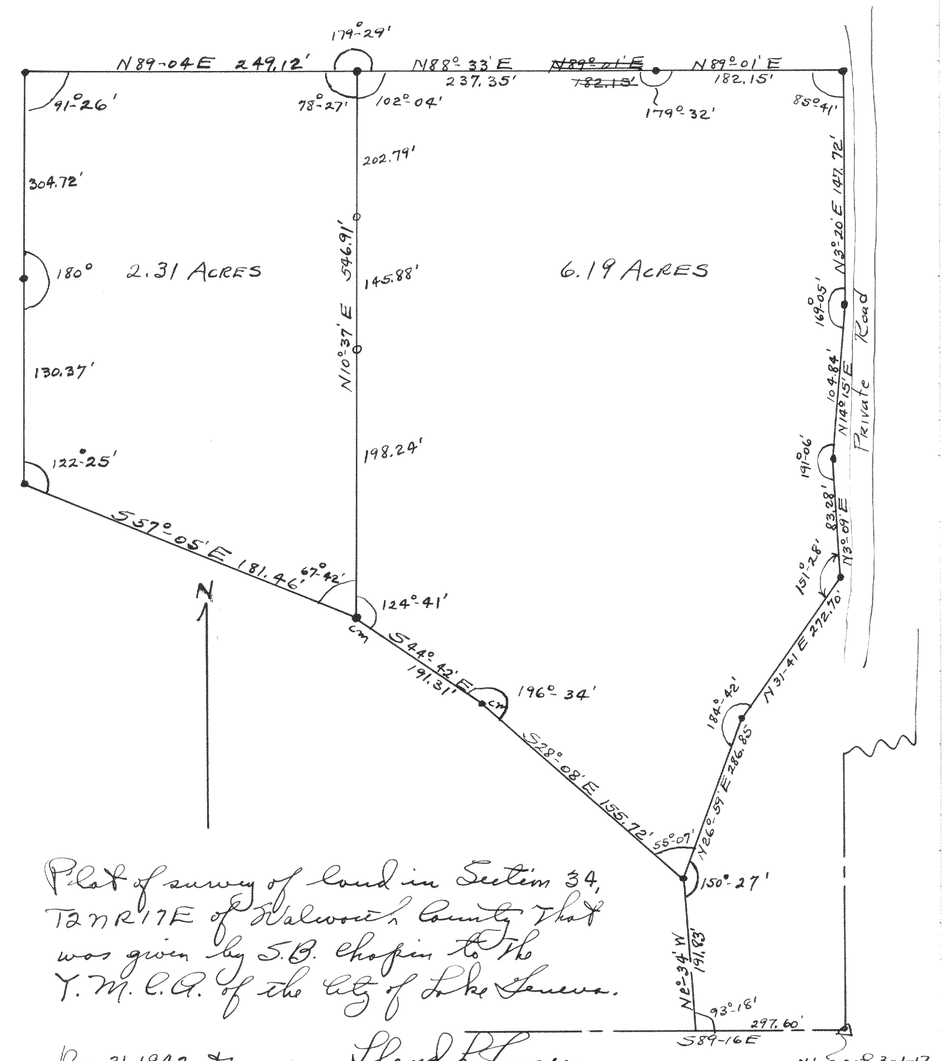

Located this cor. from Sec. East & West of this point.

Plat of survey of land in Section 34, T2NR17E of Walworth County That was given by S.B. Chapin to the Y.M.C.A. of the City of Lake Geneva.

Dec. 31, 1942 &
Nov. 16, 1944

Lloyd L. Jensen
County Surveyor