
#1514

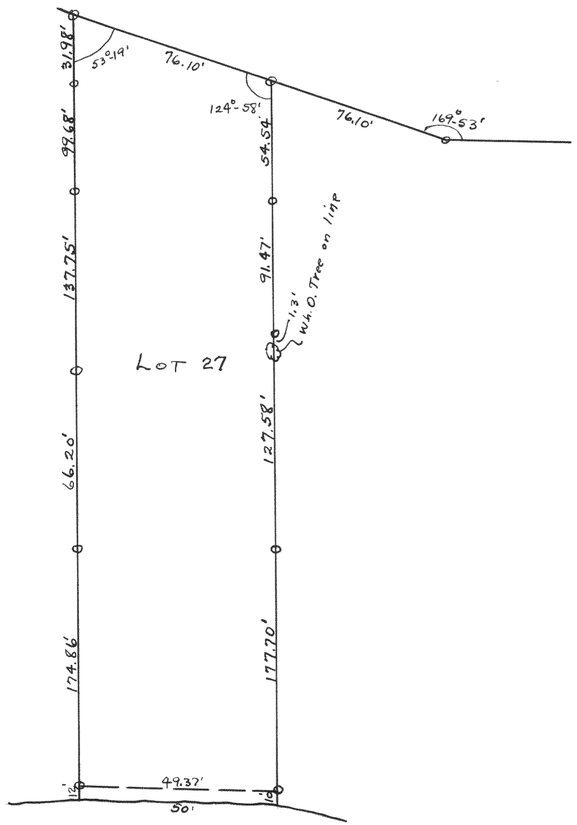


Potter's Lake

Plat of survey of Lot 27 of Block 1 of Miramar Subd., to locate the front corners & located SW. corner of the Subd and measured Easterly along the shore line to Lot 21, found an overrun of 1.2' due to the change in the shore-line. I gave 0.6' of the overrun to lots West of Lot 27 and 0.6' to the lots East of Lot 27. Lot 27 is a Park lot for the use of the Property owners.

June 14, 1944

Floyd L. Jensen
County Surveyor

#1515

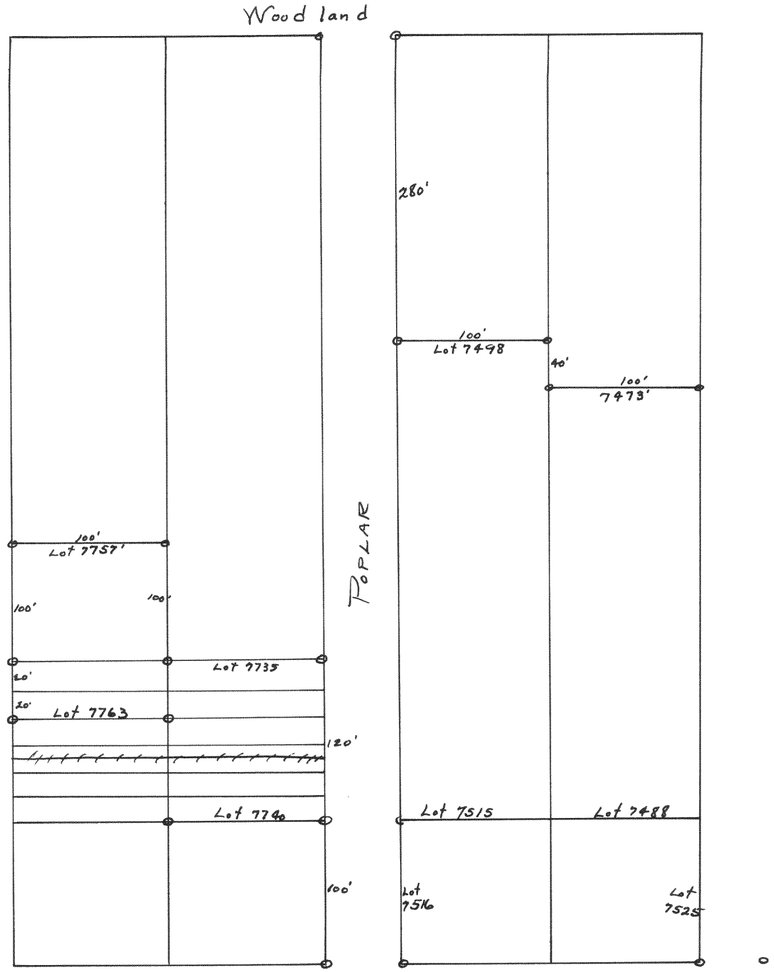

LINCOLN

Plat of survey of lots in Lake Como Beach Subd.

July 6, 1944

Floyd L. Jensen
County Surveyor