

#1518

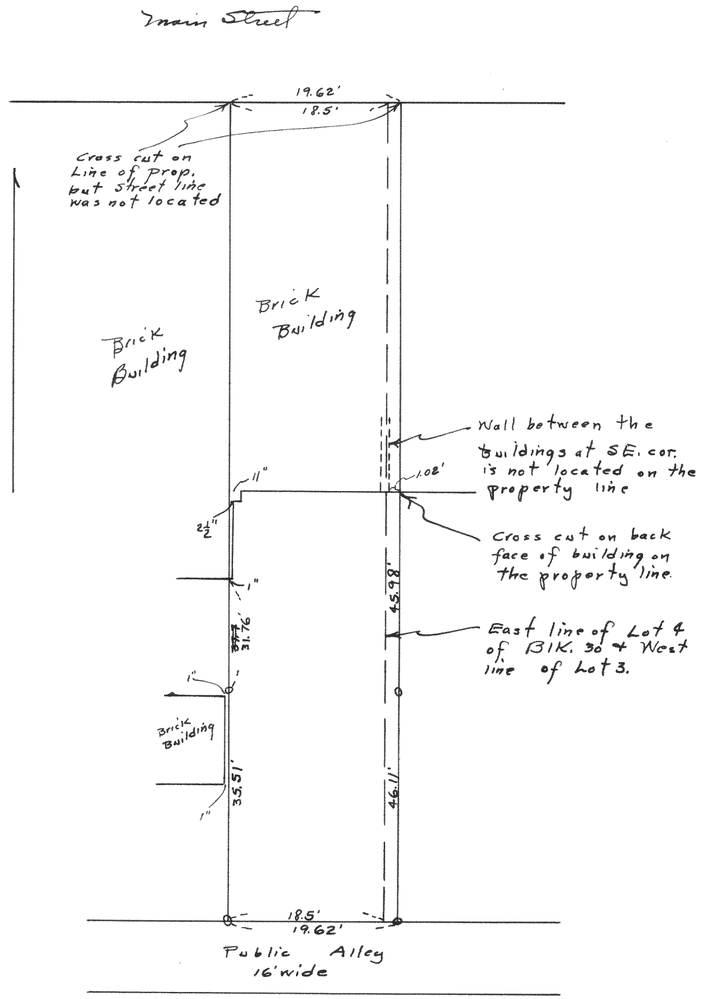

Plat of survey of part of Lots 3 & 4 of Blk 30 of the original plat of the City of Lake Geneva.
Sept. 1944

Lloyd L. Jensen
County Surveyor

#1519

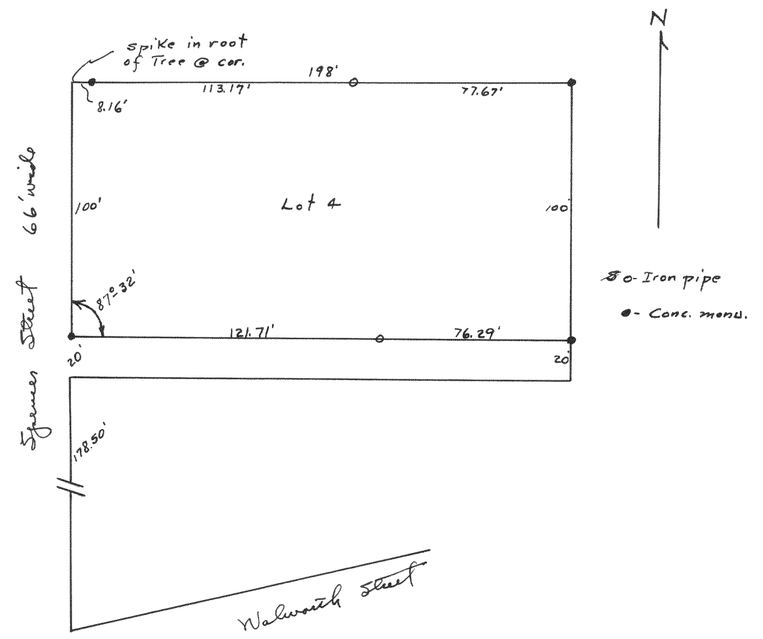

Plat of Survey of Lot 4 of Alicia Ogden's Addition to the City of Elkhorn

Aug. 1945

Lloyd L. Jensen
County Surveyor