

SURVEY NO. 1218

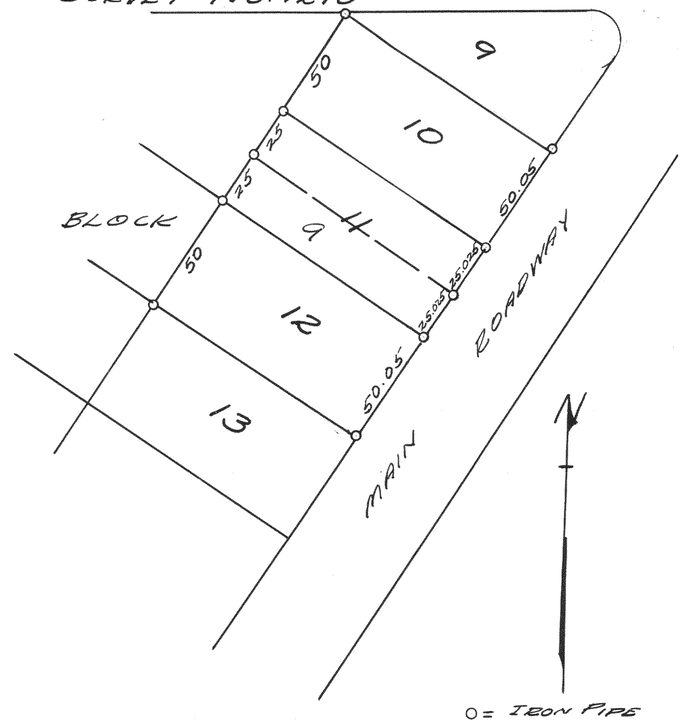

PLAT OF SURVEY OF LOTS 10, 11 & 12, OF BLOCK 9 OF SUNSET HILLS SUBDIVISION, LOT 11 WAS DIVIDED.
JULY 22, 1941

Lloyd L. Jensen
H.E.J.

SURVEY NO. 1219

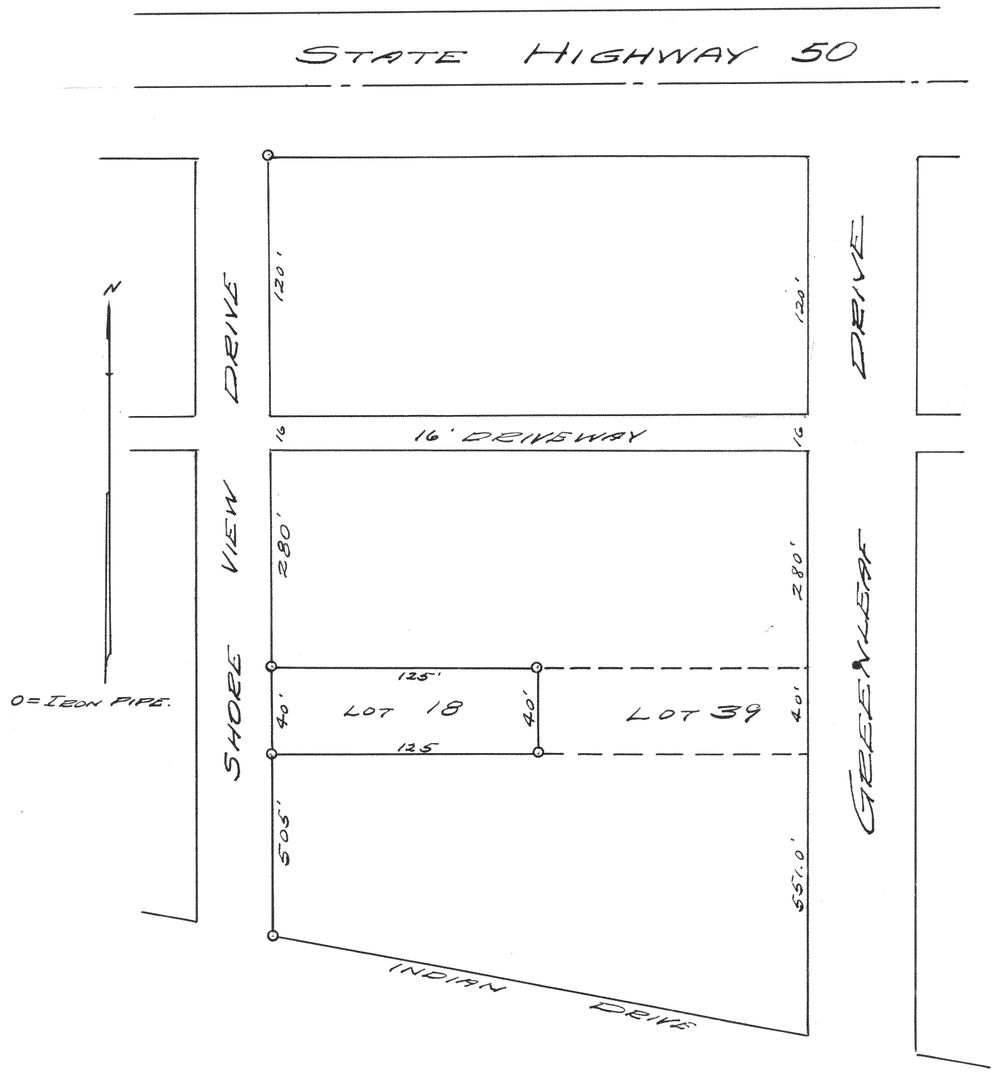

PLAT OF SURVEY OF LOT 18 BLOCK "I" CISCO BEACH SUBD., WAUKESHA CO., WISC.

MARCH 8, 1941

Lloyd L. Jensen
H.E.J.