
#1520

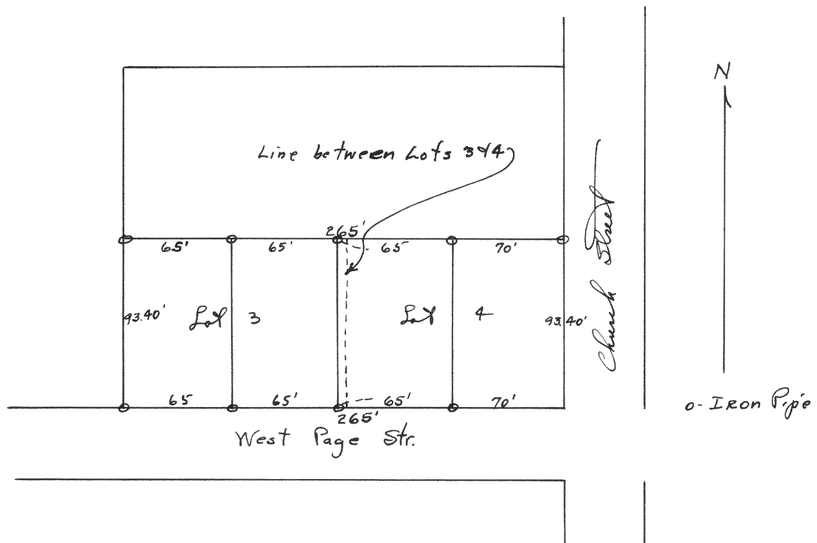


Plat of survey of the division of Lots 3 & 4 of Blk. 6 of the original plat of Elkhorn.

Nov. 1946

Lloyd L. Jensen
County Surveyor

#1521

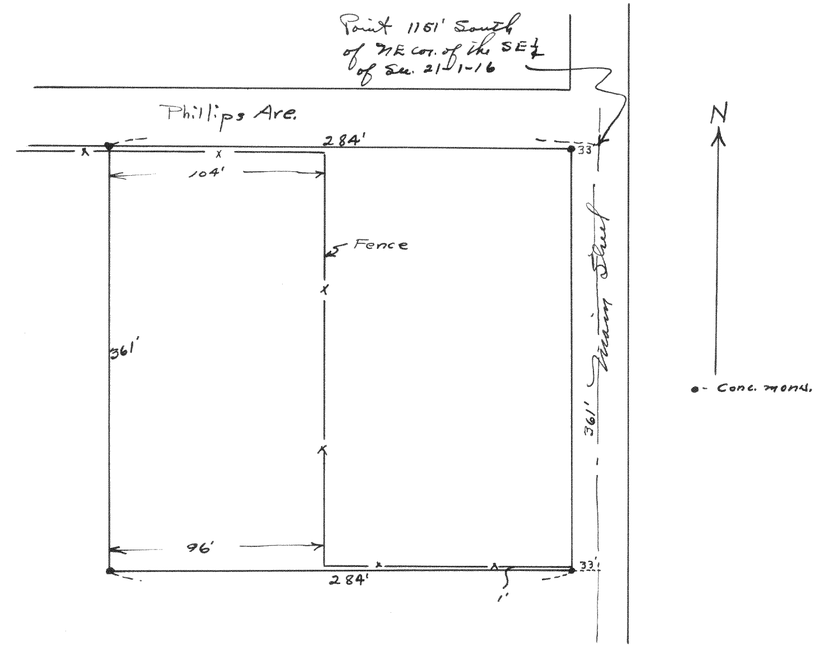

Plat of survey of land located in the SE¼ of Section 21-1-16.

Jan. 1946

Lloyd L. Jensen
County Surveyor