
#1522

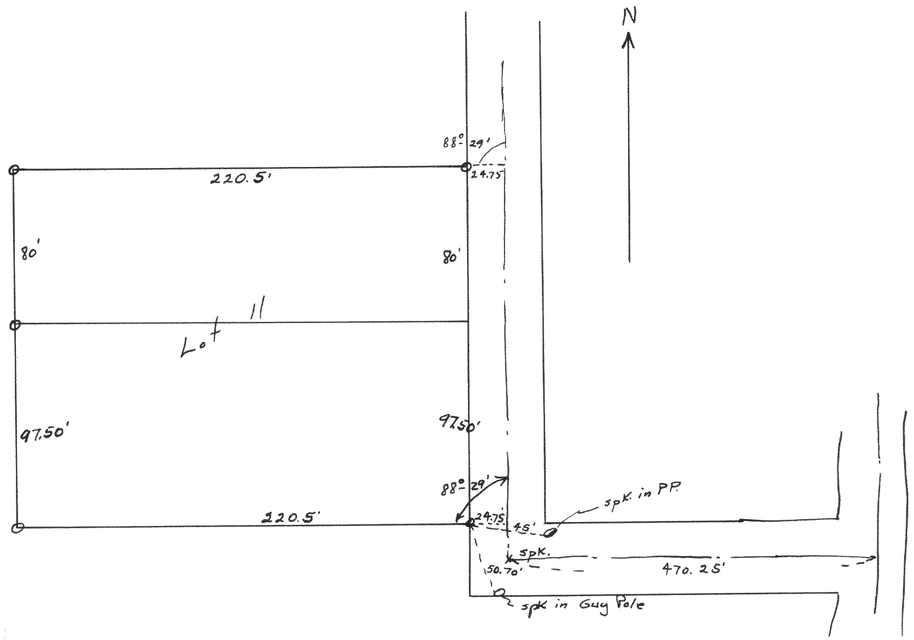


Plat of survey of Lot 11 of Phillips Add. to The Village of Walworth.

Sept. 1945

Lloyd A. Jensen
County Surveyor

#1523

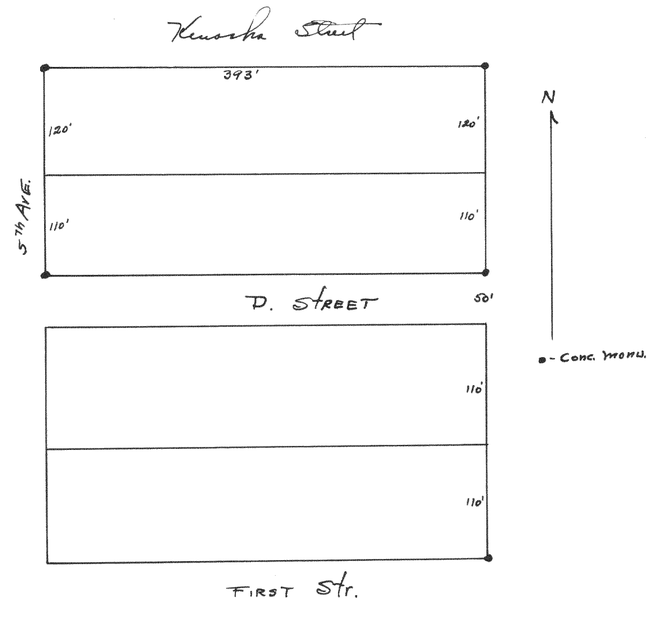

Plat of survey of part of East Side Addition to Locate block corners.

Nov. 1945

Lloyd A. Jensen
County Surveyor