
#1527

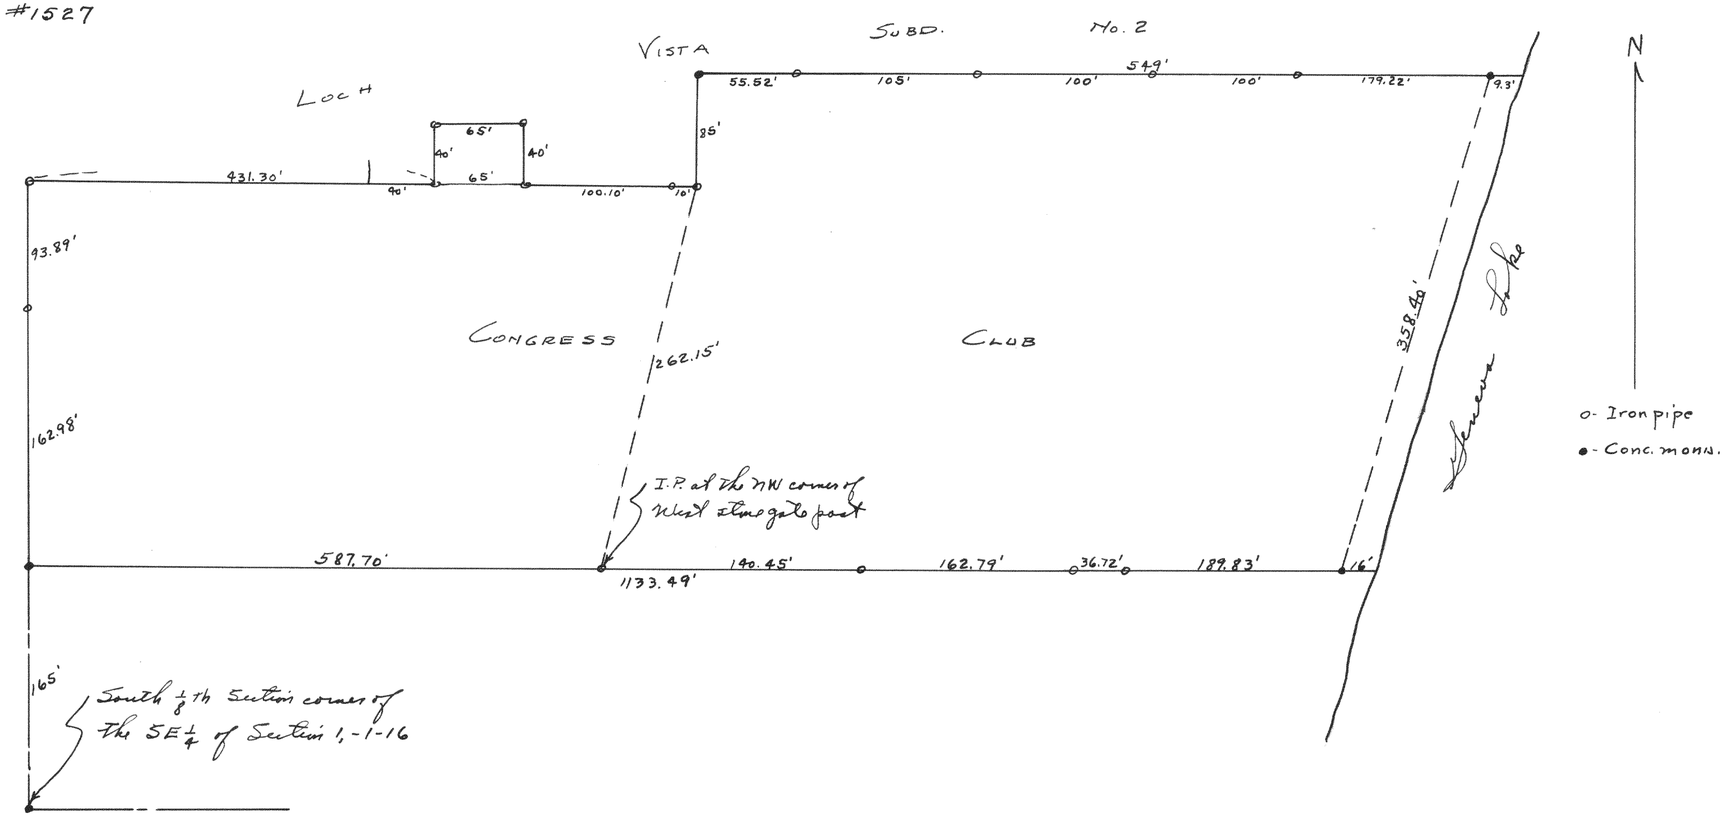

Plat of survey of land owned by the Congress Club and located in the East 1/2 of the SE 1/4 of Section 1-1-16 in the Village of Williams Bay, Walworth County Wisconsin

Oct. 27, 1945

Lloyd L. Jensen
County Surveyor