
#1528

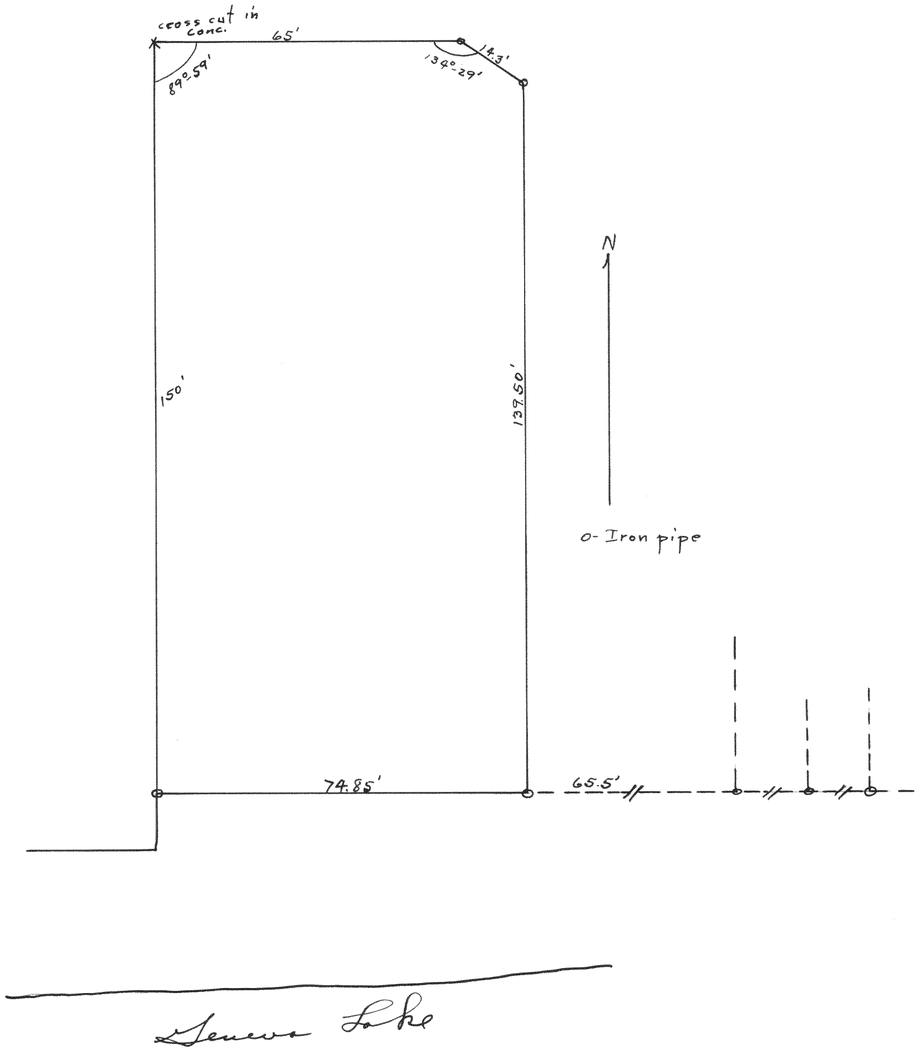


Plat of survey of Lot 63 of Cedar Point Park Subdivision, Williams Bay Wis.

Dec. 1945

Floyd L. Jensen
County Surveyor

#1529

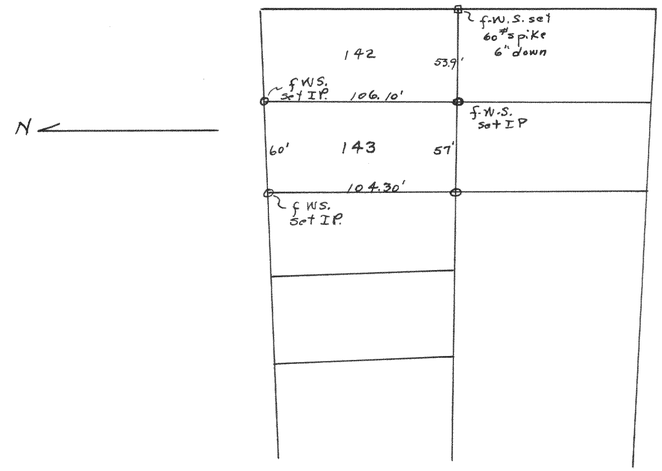


Plat of survey of Lot 143 of 2nd Add. to Cedar Point Park Subd.

Floyd L. Jensen
Co. Surveyor.

Oct. 1945.

#1530

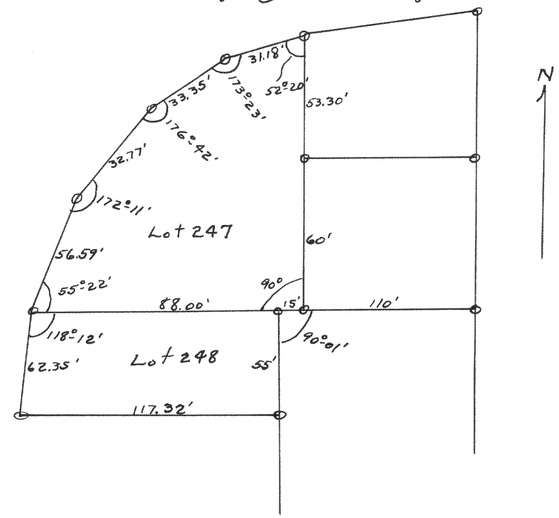

Plat of survey of lots 247 and 248 of the 3rd Addition to Cedar Point Park Subd.

Oct. 1945

Floyd L. Jensen
County Surveyor