#1531

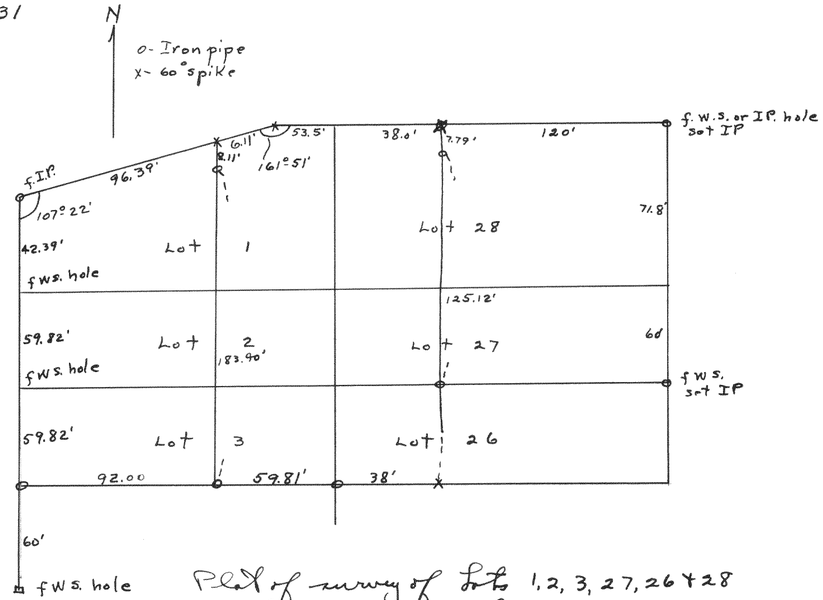

Plat of survey of Lots 1, 2, 3, 27, 26 & 28 of Harbor View Subd., Williams Bay Wisconsin.

May 28, 1945

Lloyd S. Jensen
County Surveyor

#1532

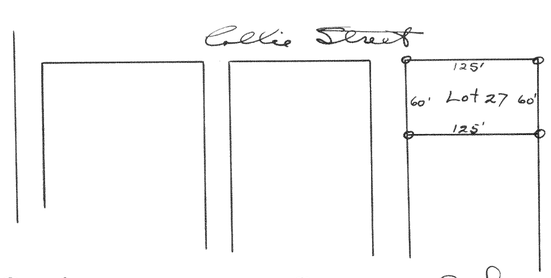

Plat of survey of Lot 27 of Lockey Bros. Subd., Williams Bay Wis.

9-18-45

Lloyd S. Jensen
County Surveyor

#1533

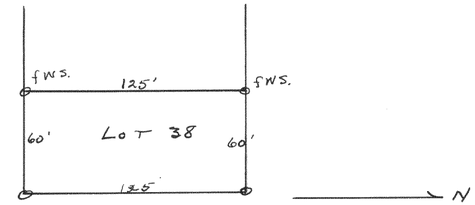

Plat of survey of lot 38 of Lockey Bros. Subdivision, Williams Bay Wisconsin.

Sept. 1945

Lloyd S. Jensen
County Surveyor

#1534

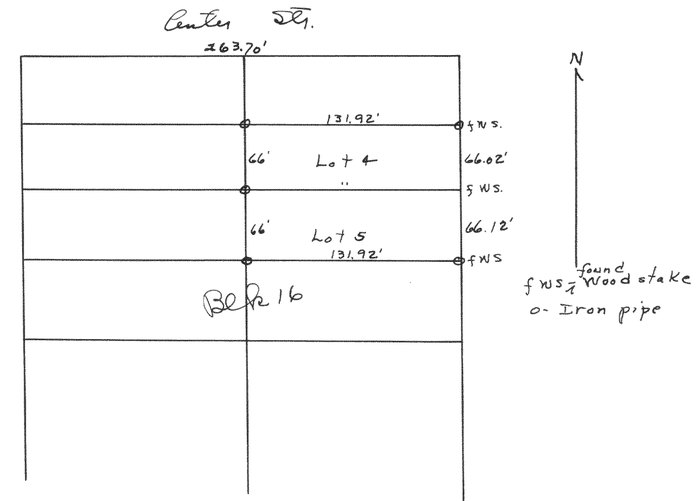

Plat of survey of Lts. 4 & 5 of Blk 16 of Williams 2nd Add. to Williams Bay.

Sept. 8, 1945

Lloyd S. Jensen
County Surveyor