
#1535

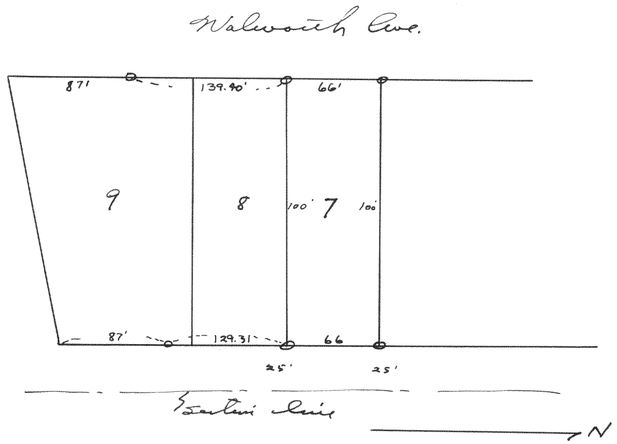


Plat of survey of lot 7 of Blk 1 of Original plat of Williams Bay Wisconsin

Nov. 1945

Lloyd S. Jensen
County Surveyor

#1536

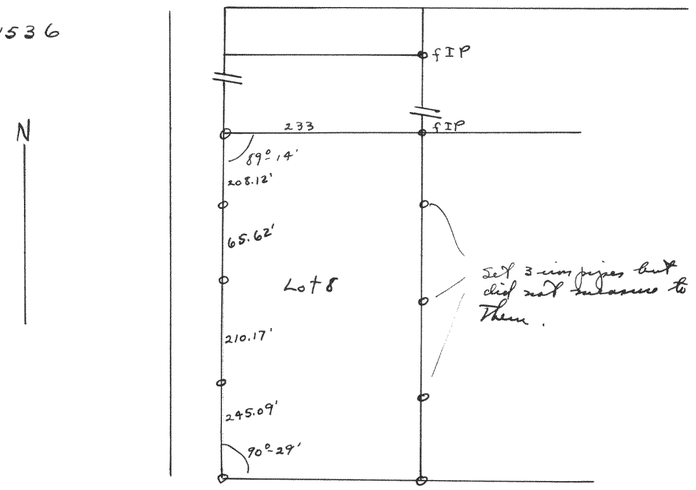


Plat of survey of lot 8 of Blk 3 of Rowena Park Subd.

Sept. 1945

Lloyd S. Jensen
County Surveyor.

#1537

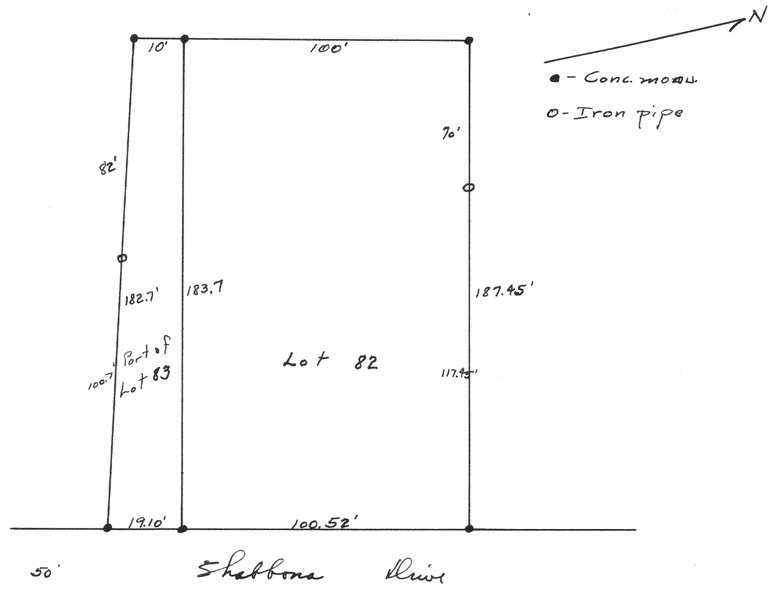


Plat of survey of Lot 82 and part of lot 83 of Unit No. 2 of Country Club Estates, Fontana Wis.

Nov. 1945

Lloyd S. Jensen
County Surveyor

#1538

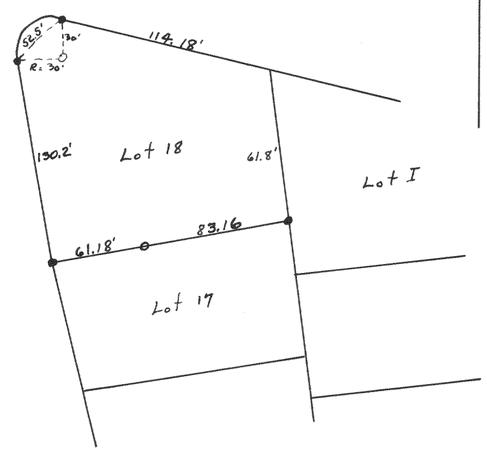

Plat of survey of Lot 18 of Blk E of Unit 3 of Country Club Estates, Fontana Wisconsin.

Nov. 26, 1945

Lloyd S. Jensen
County Surveyor