

#1539

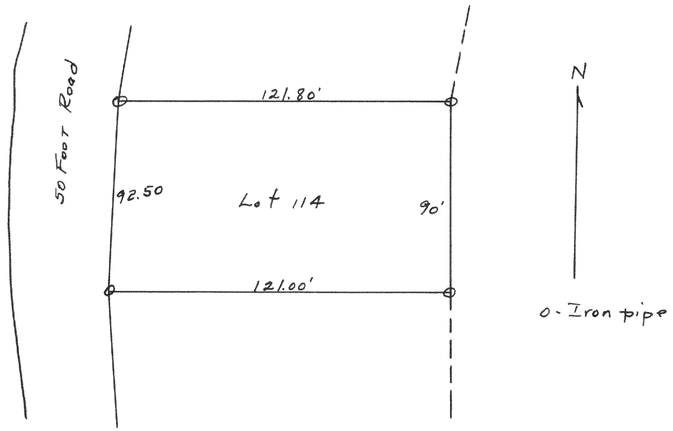


Plat of survey of Lot 114 of Unit 2 of County Club Estates, Fontana Wis.
Nov. 23, 1945
Lloyd L. Jensen
County Surveyor

#1540

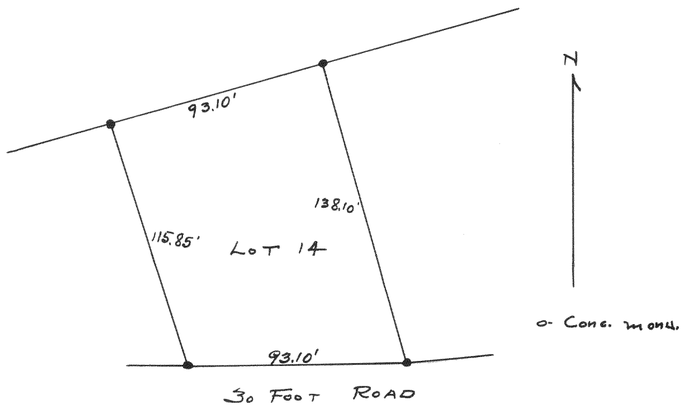


Plat of survey of survey of Lot 14 of Unit 2 of County Club Estates, Fontana Wisconsin.
Nov. 26, 1945
Lloyd L. Jensen
County Surveyor

#1541

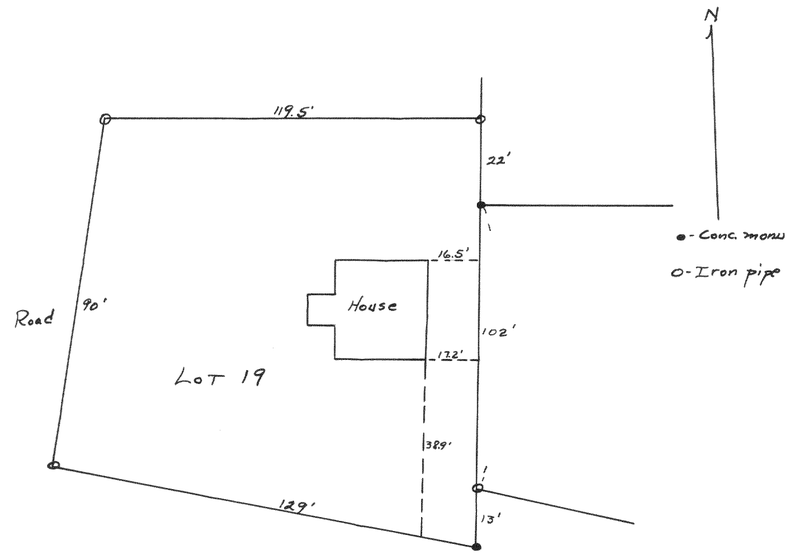

Plat of survey of Lot 19 of Block D of Unit No. 3 of County Club Estates, Fontana Wisconsin.
Nov. 26, 1945
Lloyd L. Jensen
Co. Surveyor

#1542

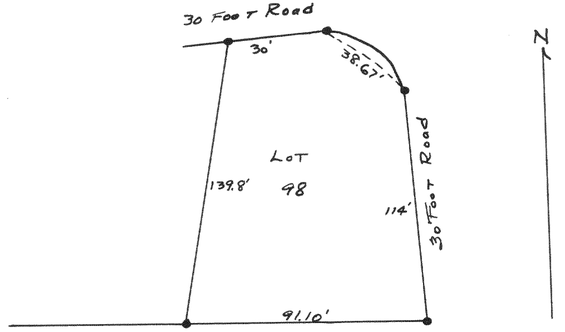

Plat of survey of Lot 98 of Unit 2 of County Club Estates, Fontana Wisconsin
Dec. 13, 1945
Lloyd L. Jensen
County Surveyor