

#1543

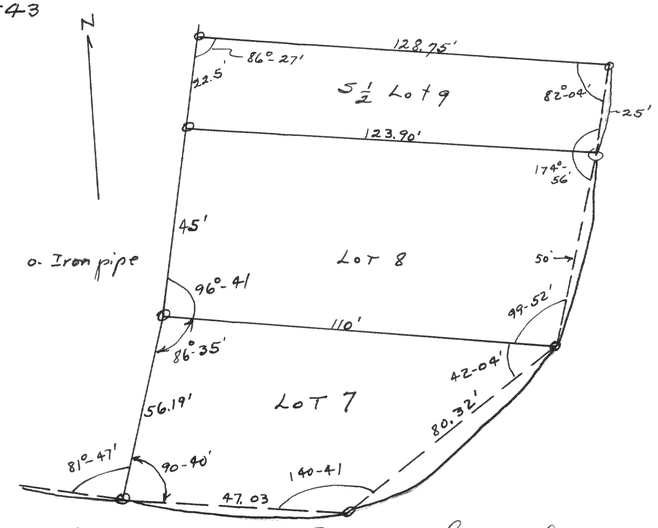

Plat of survey of Lot 7, 8 & the South ½ of Lot 9 of Blk. 3 of Indian Hills Subd.
Nov. 28, 1945

Floyd S. Jensen
Co. Sur.


#1544

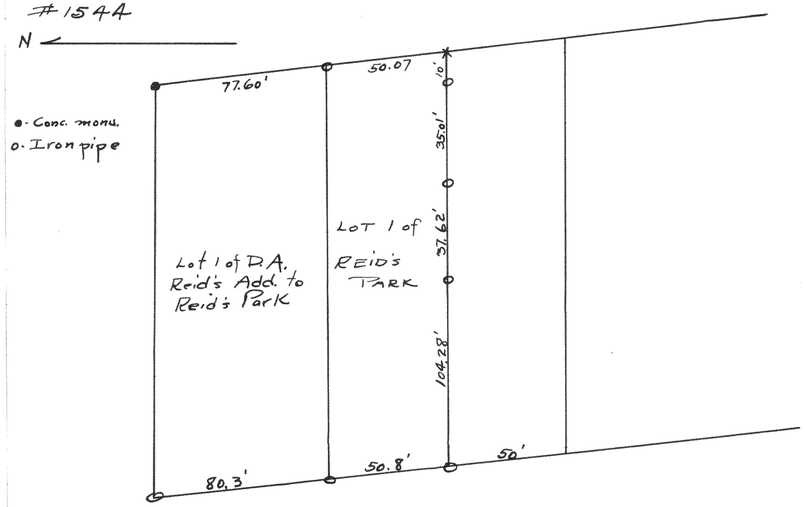

Plat of survey of Lot 1 of Reid's Park, Village of Fontana Wisconsin.
Jan. 26, 1946

Floyd S. Jensen
County Surveyor

#1545

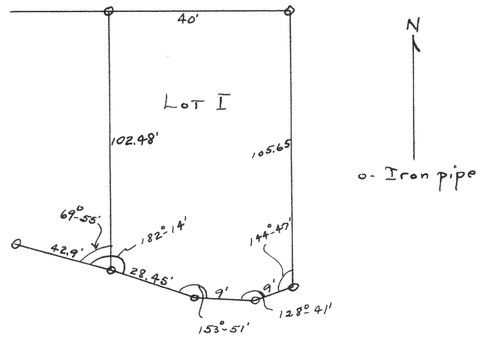


Plat of survey of Lot 1 - Blk 13 of Glenwood Springs Subdivision, Fontana Wis.

Oct. 20, 1945

Floyd S. Jensen
County Surveyor

#1546

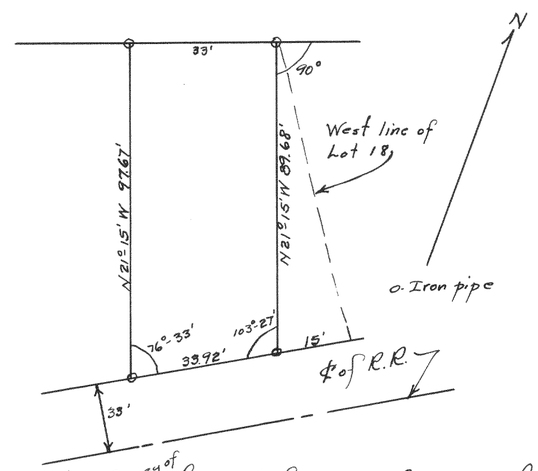

Plat of survey of part of Blk 4 of Tujips 2nd Add to the City of Whitewater Wisconsin.

Oct. 25, 1945

Floyd S. Jensen
County Surveyor