
#1547

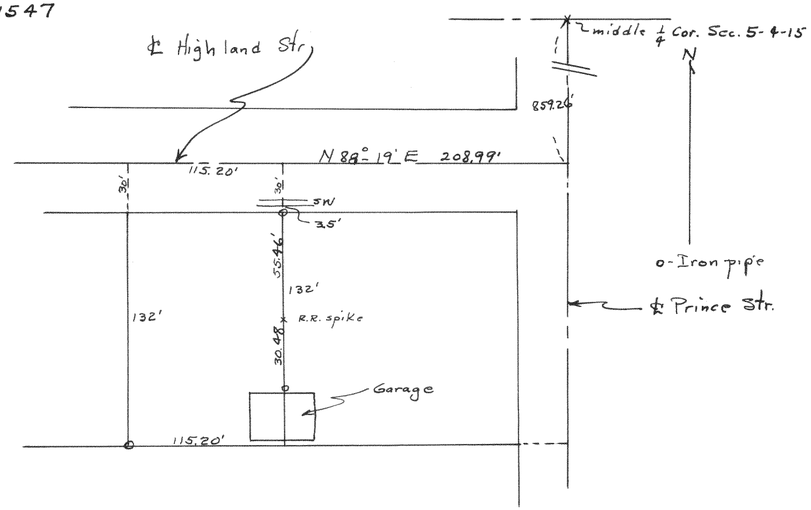


Plat of survey of land located in the SW¼ of Section 5, T4N R15E, Whitewater Wis.

July 1945

Lloyd L. Jensen
County Surveyor

#1548

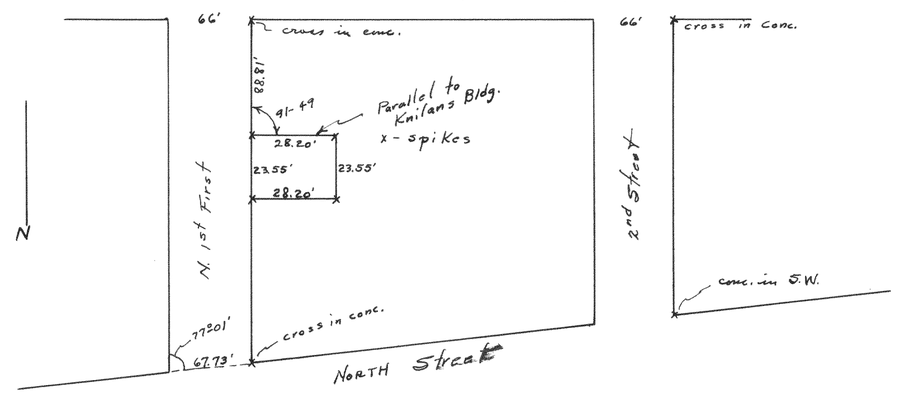


Plat of survey of part of Lot 1 of Blk. 2 of Original plat of Whitewater Wisconsin

Nov. 1945

Lloyd L. Jensen
County Surveyor

#1549

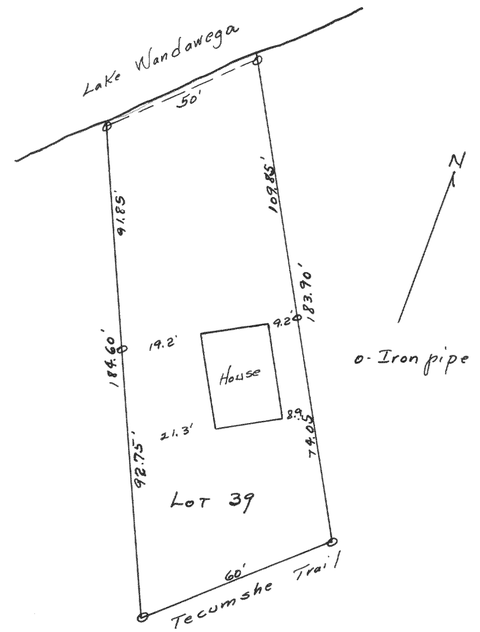


Plat of survey of Lot 39 of Blk. I of Lake Wandawega Highlands, located in Sections 11 & 12, T37N R16E.

Oct. 1945

Lloyd L. Jensen
County Surveyor

#1550

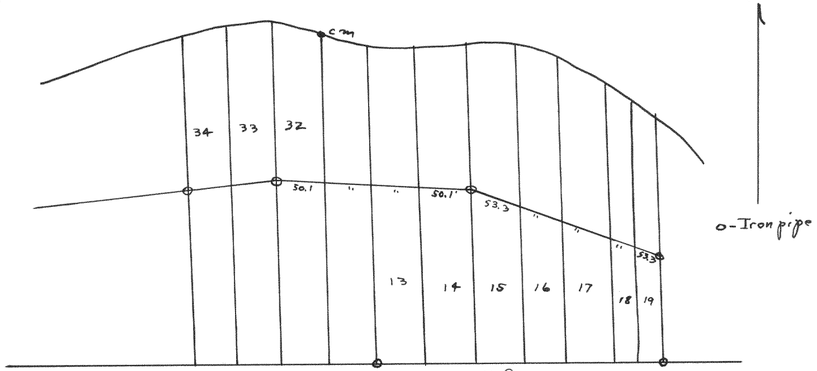

Plat of survey of lots of Blk 4 of Lake Wandawego Highlands.

April 4, 1945

Lloyd L. Jensen
County Surveyor