
SURVEY No. 1185

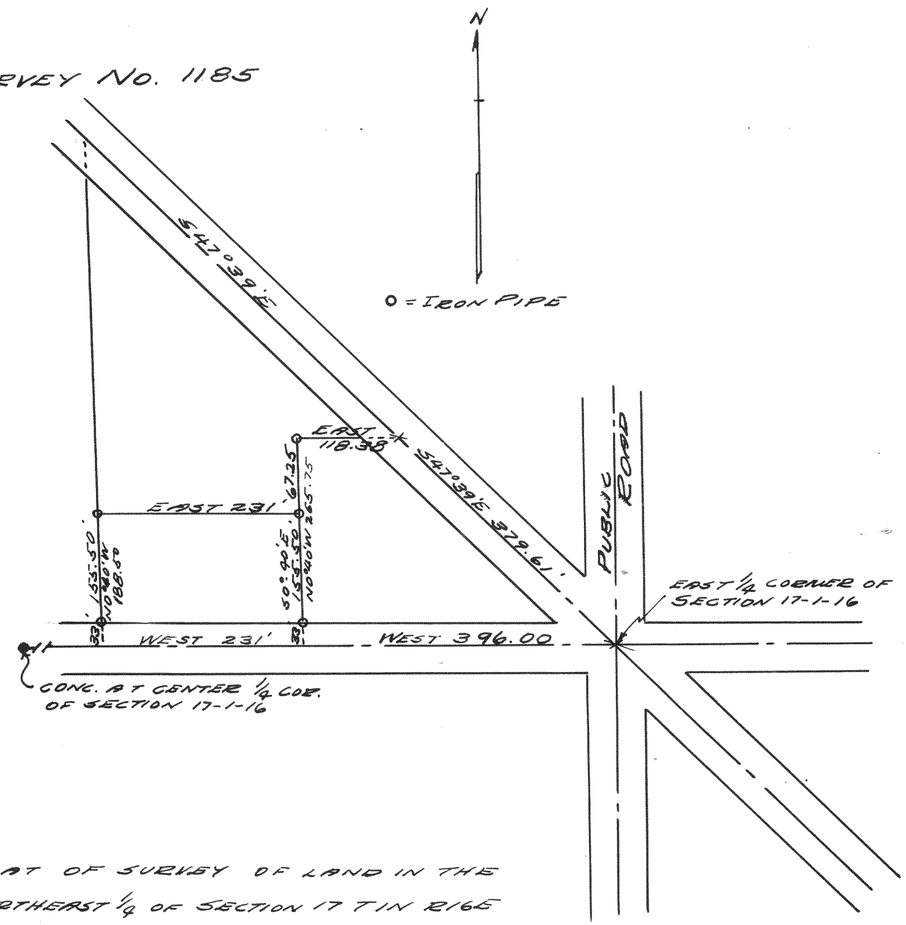


PLAT OF SURVEY OF LAND IN THE NORTHEAST 1/4 OF SECTION 17 T 1N R16E OF WALWORTH COUNTY, WISCONSIN.

DEC. 12, 1941

Lloyd L Jensen
N.E.J.

SURVEY No. 1186

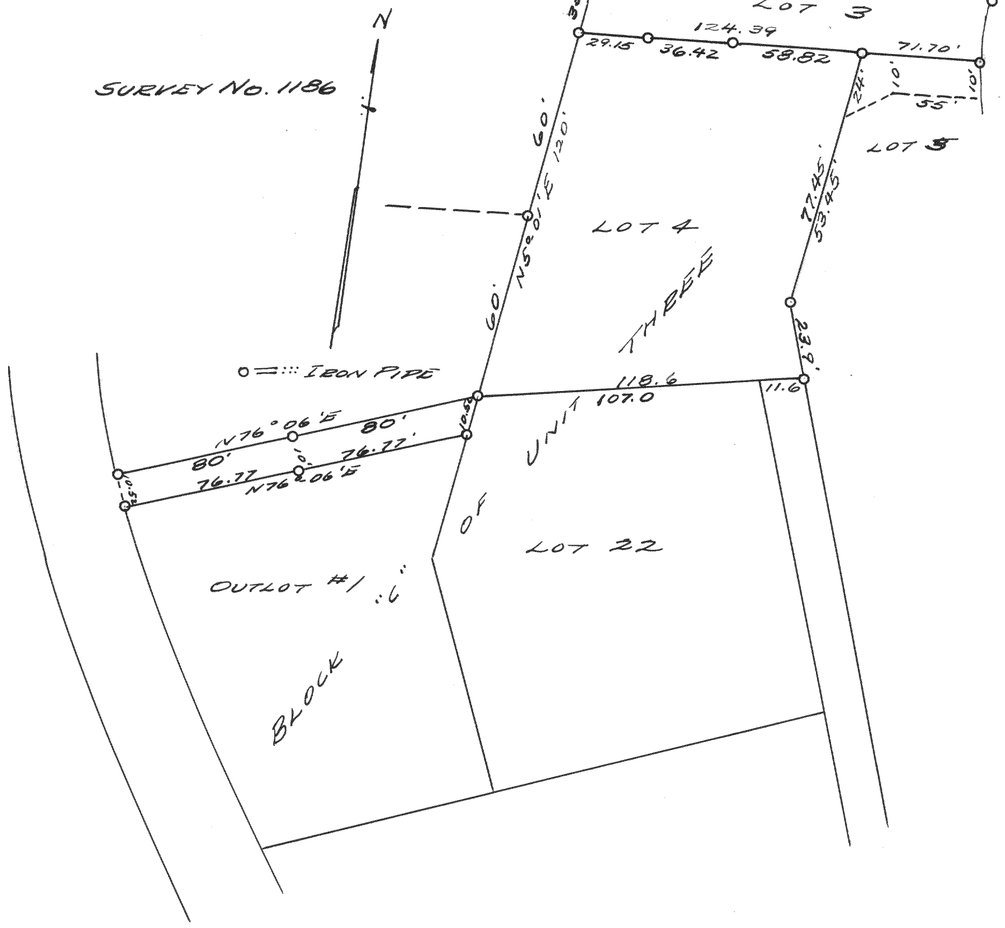

PLAT OF SURVEY OF PART OF OUTLOT #1 AND LOT 5 AND OF ALL OF LOT 4 ALL IN BLOCK "C" OF UNIT 3 OF COUNTRY CLUB ESTATES IN THE VILLAGE OF FONTANA-ON-GENEVA LAKE, WALWORTH CO. WISC.
SEPT 26, 1941

Lloyd L Jensen
N.E.J.