

#1554

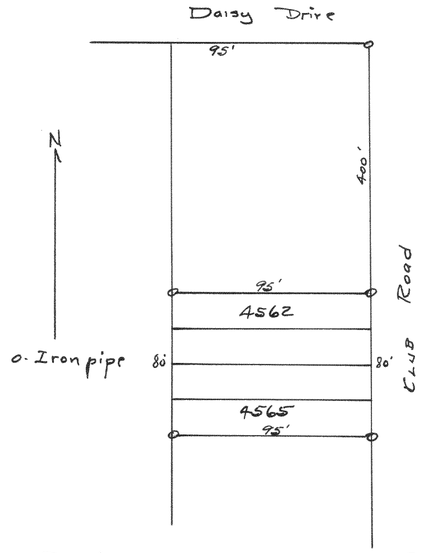

Plat of survey of Lots in Lake Como Beach Subd.
Oct. 1945

Lloyd L. Jensen
County Surveyor


#1555

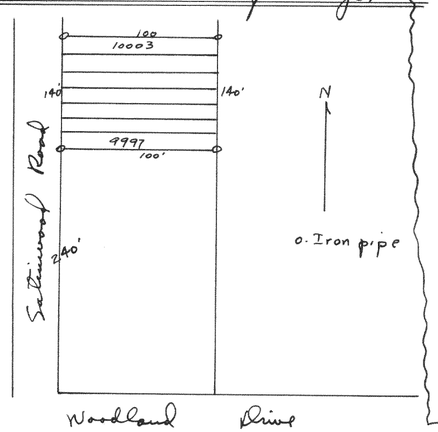

Plat of survey of lots in Lake Como Beach Subd.
10-15-45

Lloyd L. Jensen
County Surveyor


#1556

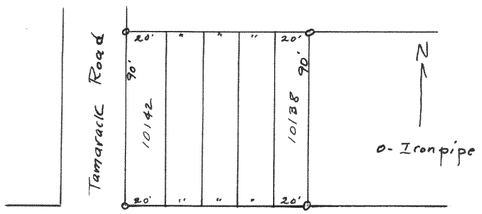

Plat of survey of lots in Lake Como Beach Subdivision.
10-29-45

Lloyd L. Jensen
County Surveyor


#1557

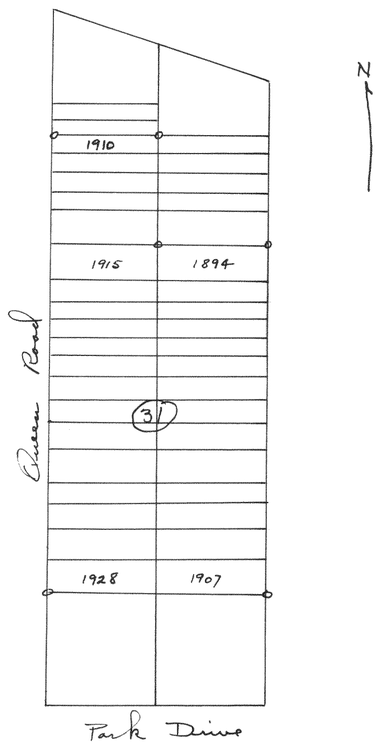

Plat of survey of lots at Lake Como Beach Subd.
Dec. 1945

Lloyd L. Jensen
County Surveyor


#1558

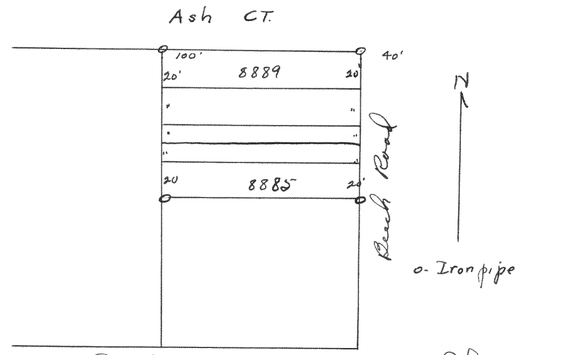

Plat of survey of lots in Lake Como Beach Subd.
10-31-45

Lloyd L. Jensen
County Surveyor

#1559

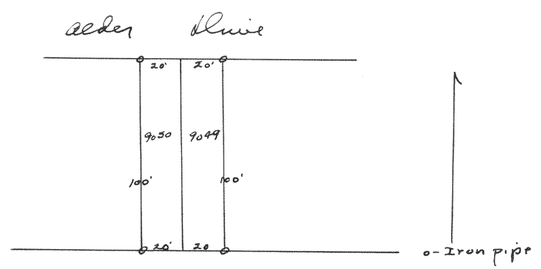

Plat of survey of lots at Lake Como Beach Subd.
10-31-45

Lloyd L. Jensen
County Surveyor