#1572

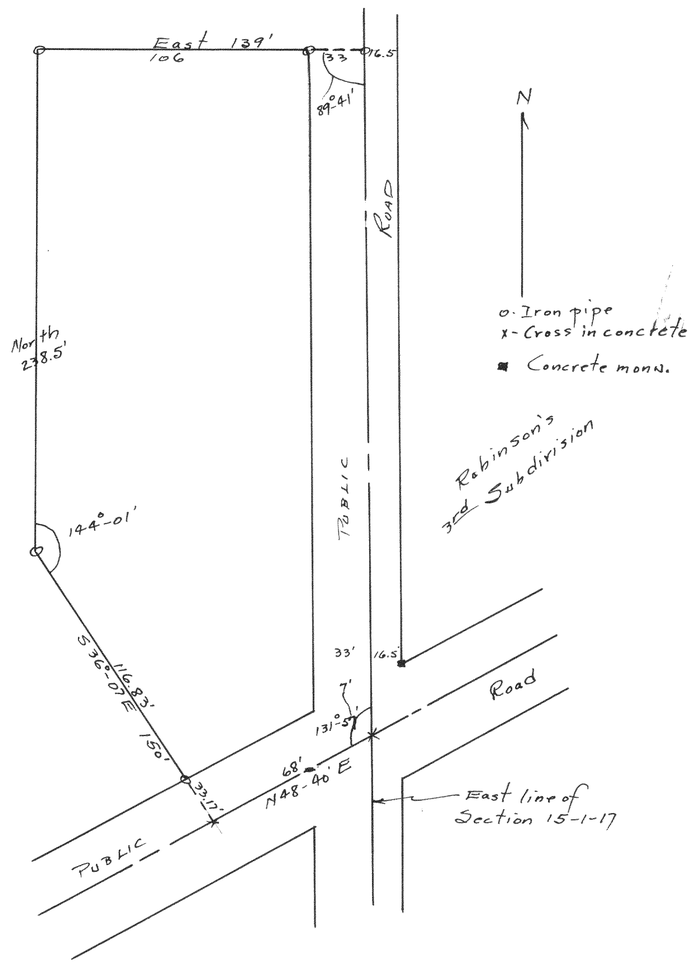

Plat of survey of land owned by Mary H. Betts located in the NE ¼ of Section 15, T1N R17E.

March 21, 1945

Floyd L. Jensen
County Surveyor

#1573

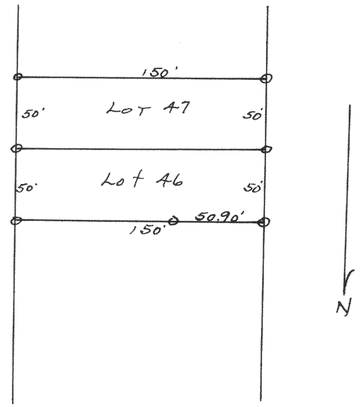

Plat of survey of Lots 46 and 47 of Lake Geneva Beach Subd., Sec. 11, T1N R17E.

Nov. 1945

Floyd L. Jensen
County Surveyor

#1574

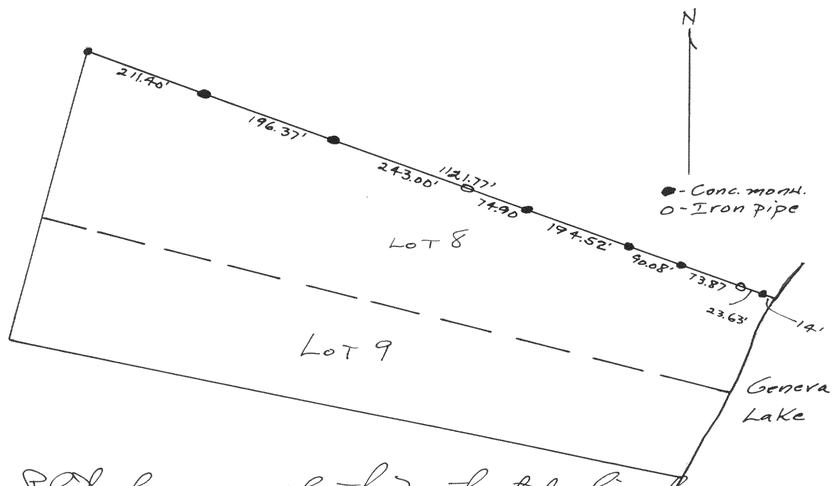

Plat of survey of the northeasterly line of Lot 8 - Blk. 4, of Geneva Park Subdivision.

Nov. 8, 1945

Floyd L. Jensen
County Surveyor