
#1575

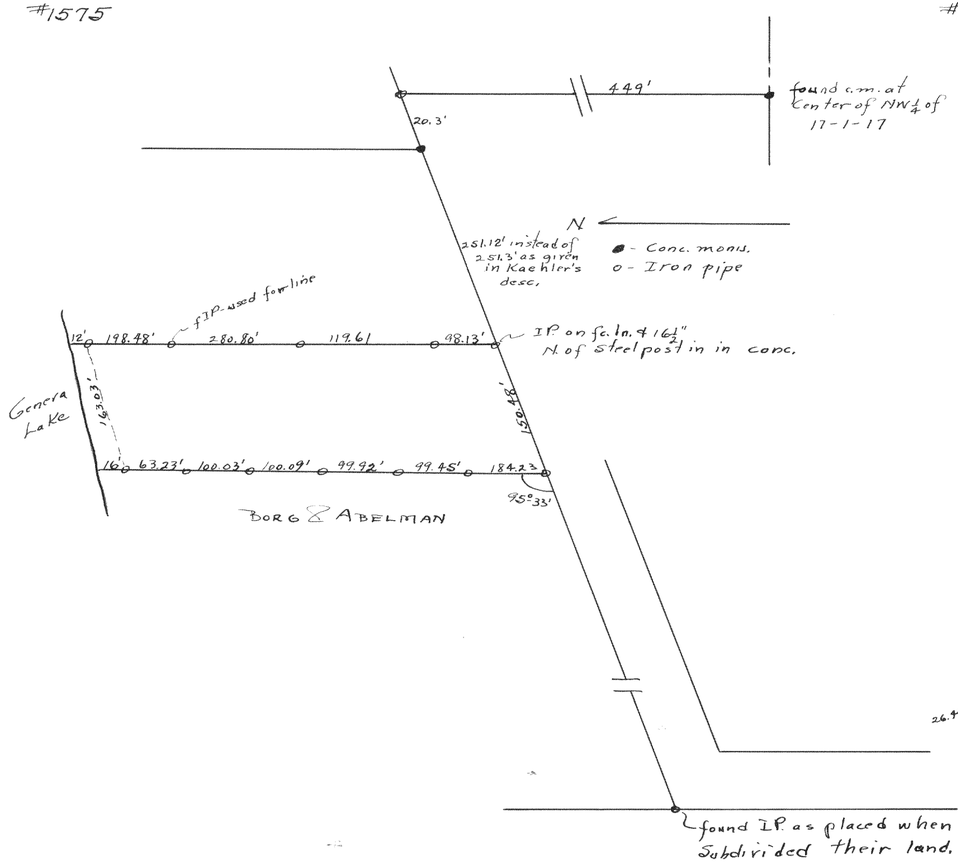


Plat of survey of part of the unrecorded plat of Kaye's Park Subd. located in the NW¼ of Section 17, T1N R17E.

June 1945

Floyd L. Jensen
County Surveyor

#1576

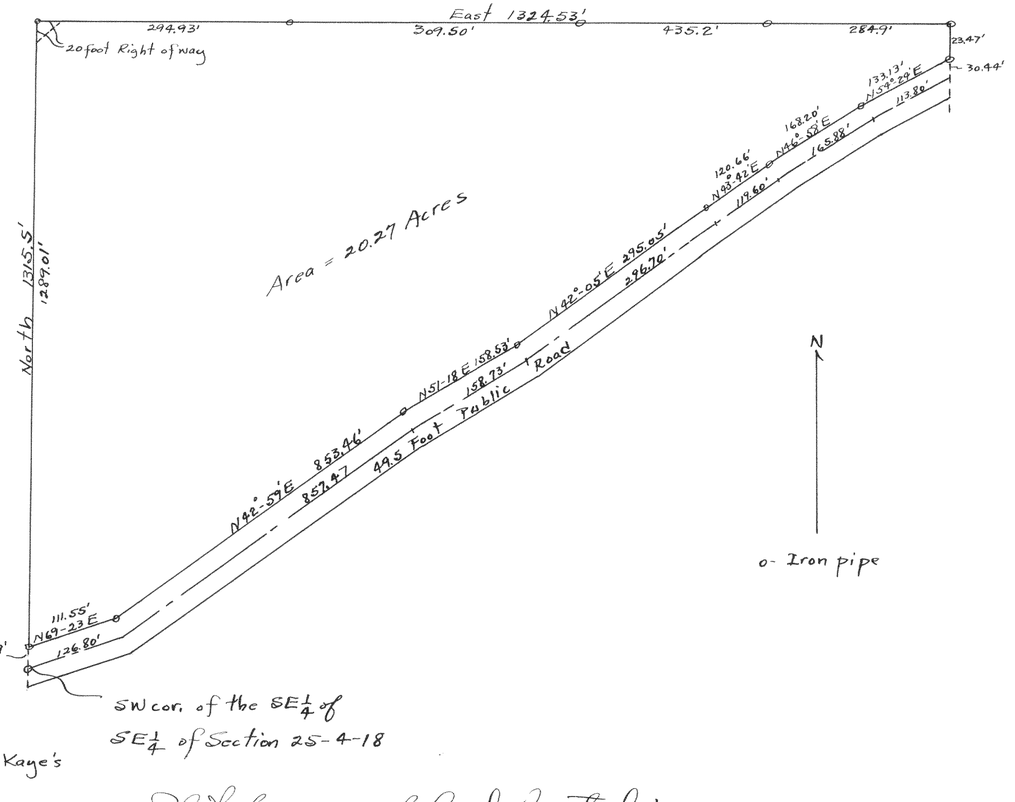

Plat of survey of land located in Section 25, T4N R18E

March 17, 1945

Floyd L. Jensen
County Surveyor