
208

#1577

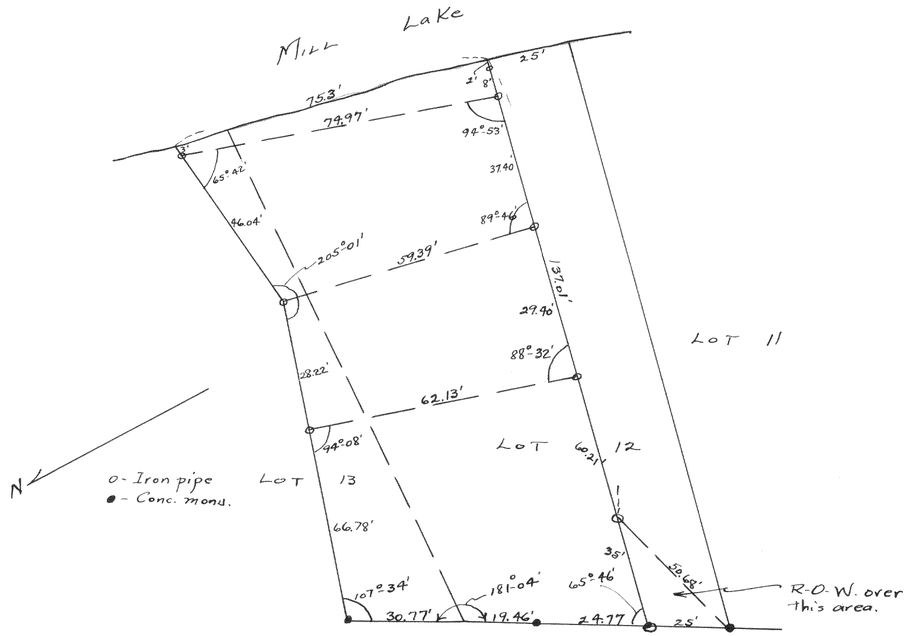


Plat of survey of part of lots 12 and 13 of Millsite Subdivision, located in Section 4, T47R18E.

Oct. 1945

Floyd S. Jensen
County Surveyor

#1578

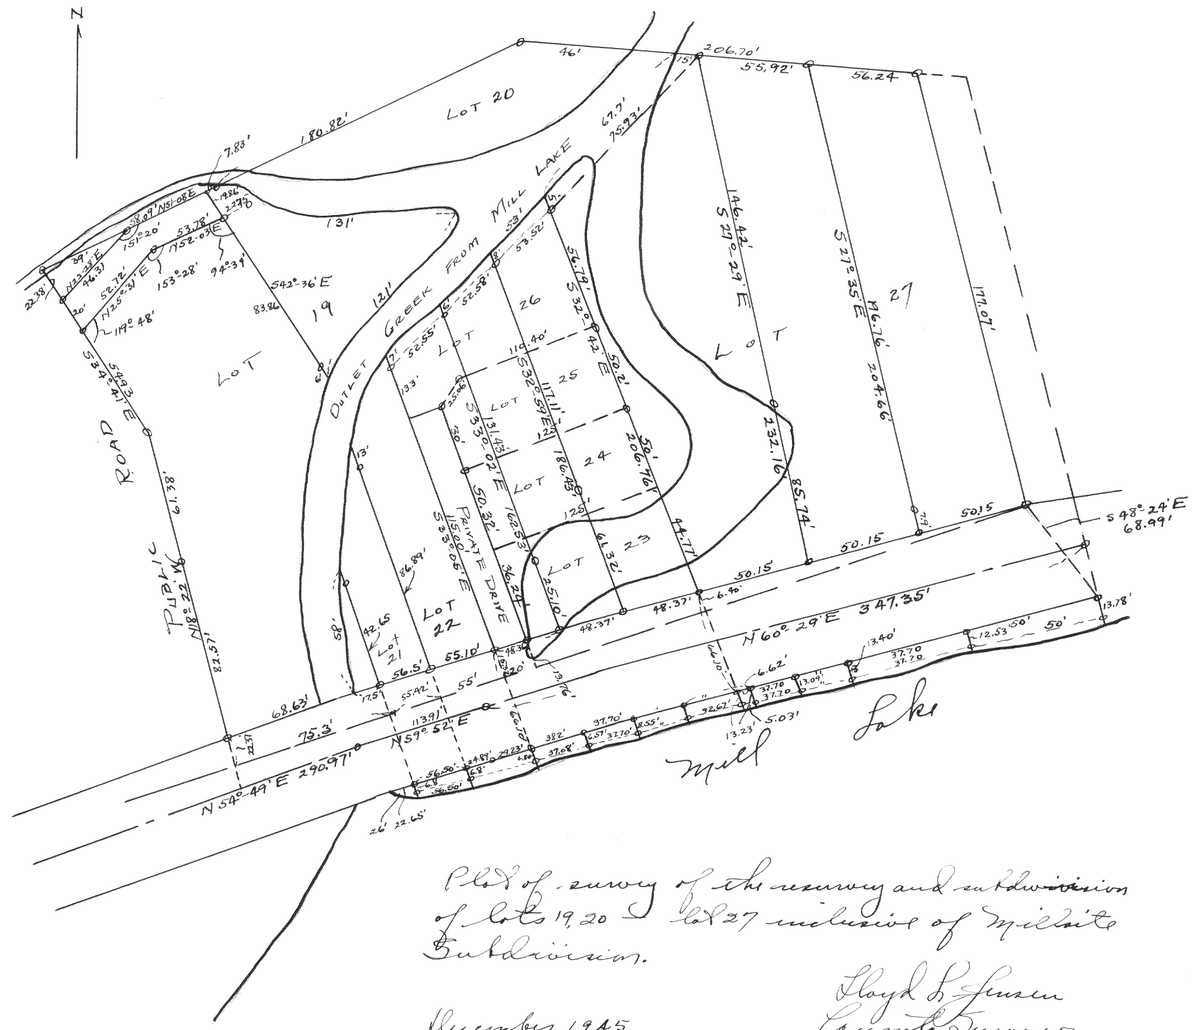

Plat of survey of the resurvey and subdivision of lots 19 20 & lot 27 inclusive of Millsite Subdivision.

December 1945

Floyd S. Jensen
County Surveyor