
#1586

Page 8.

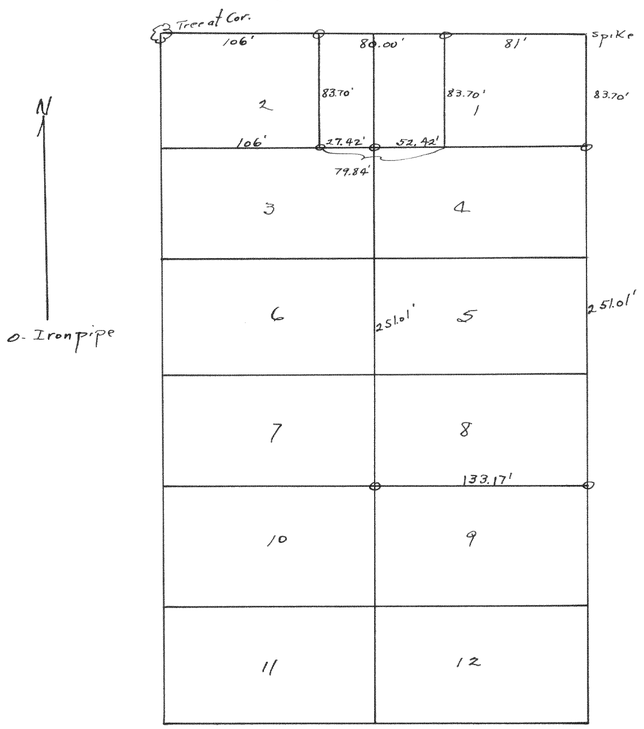


Plat of survey of part of Blk 12 of Rockwell's Add. to City of Elkhorn.

May 5, 1945

Lloyd L. Jensen
County Surveyor

#1587

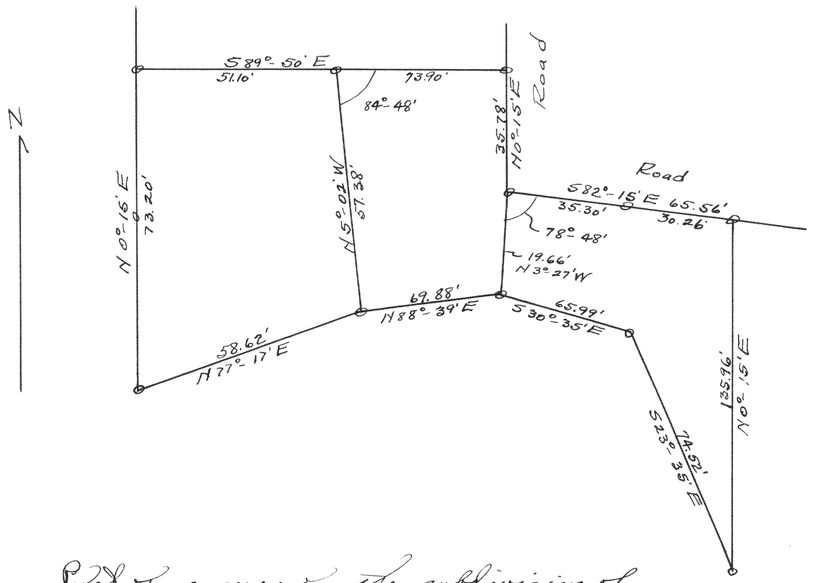

Plat of survey of the subdivision of Lot 60 of the unrecorded plat of Lockwoods Subd.

July 23, 1945

Lloyd L. Jensen
County Surveyor