

#1590

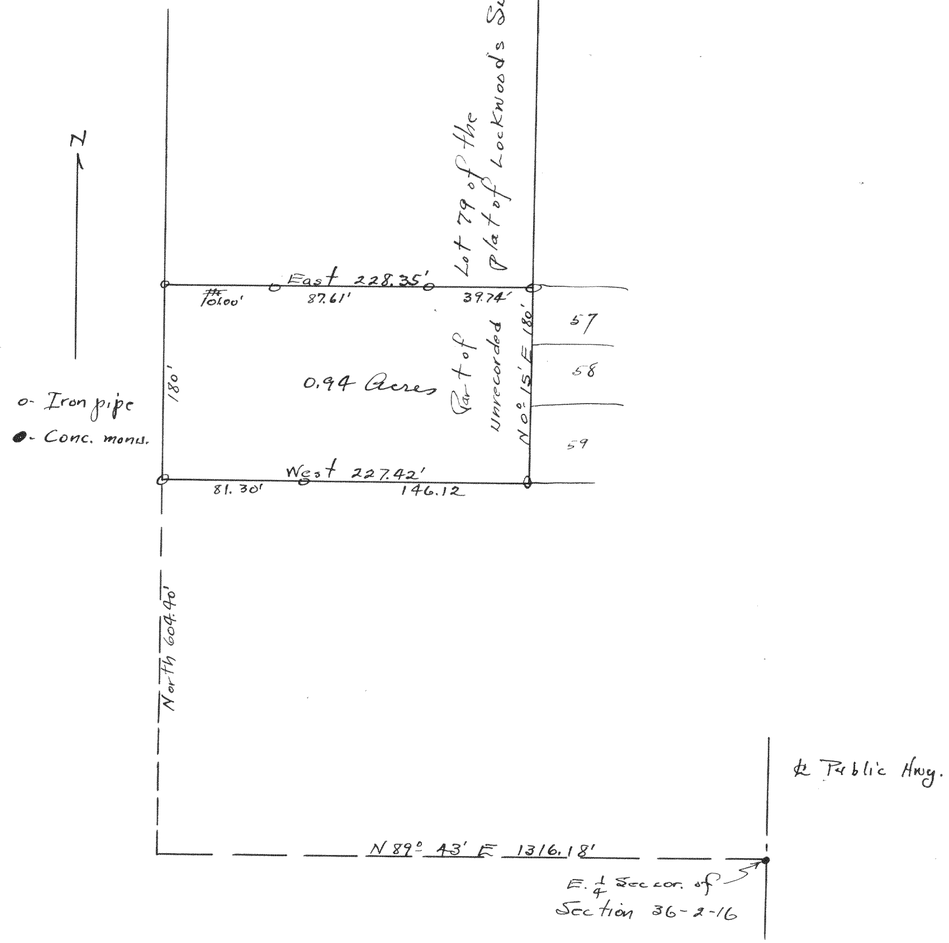

Plat of survey of part of Lot 79 of the unrecorded plat of Lockwood's Subd.
11-6-45

Floyd L. Jensen
County Surveyor

#1591

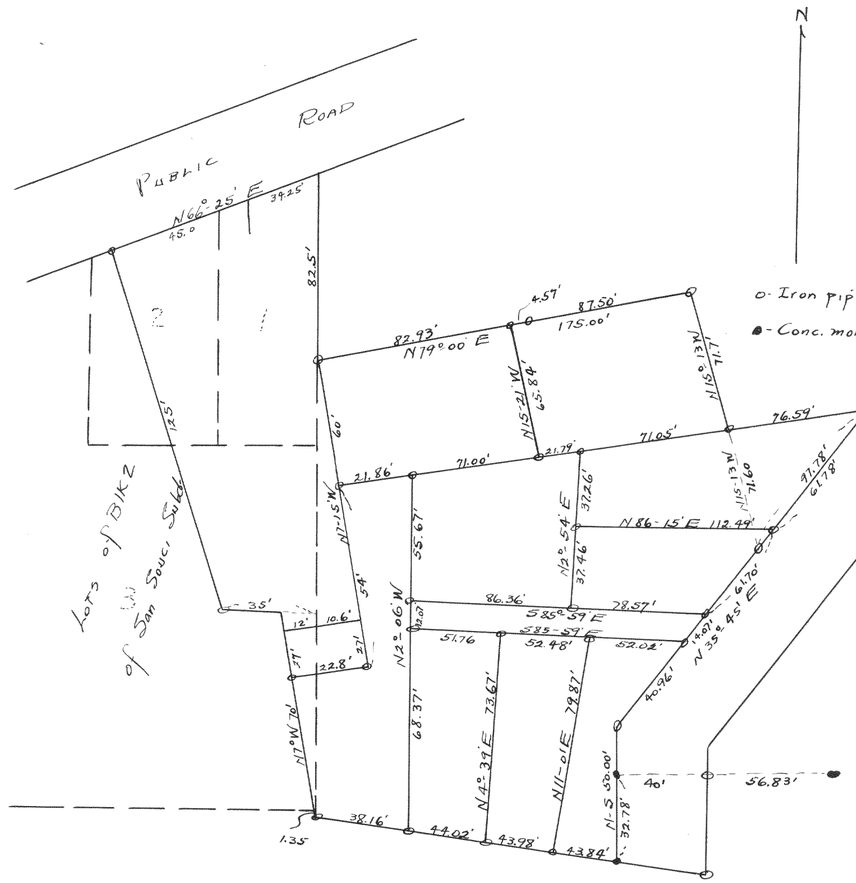

Plat of a survey of a subdivision of a parcel of land for Mrs. Lillian Anderson in Section 22, T2N R1 6E.

Aug. 16, 1945

Floyd L. Jensen
County Surveyor