
#1595

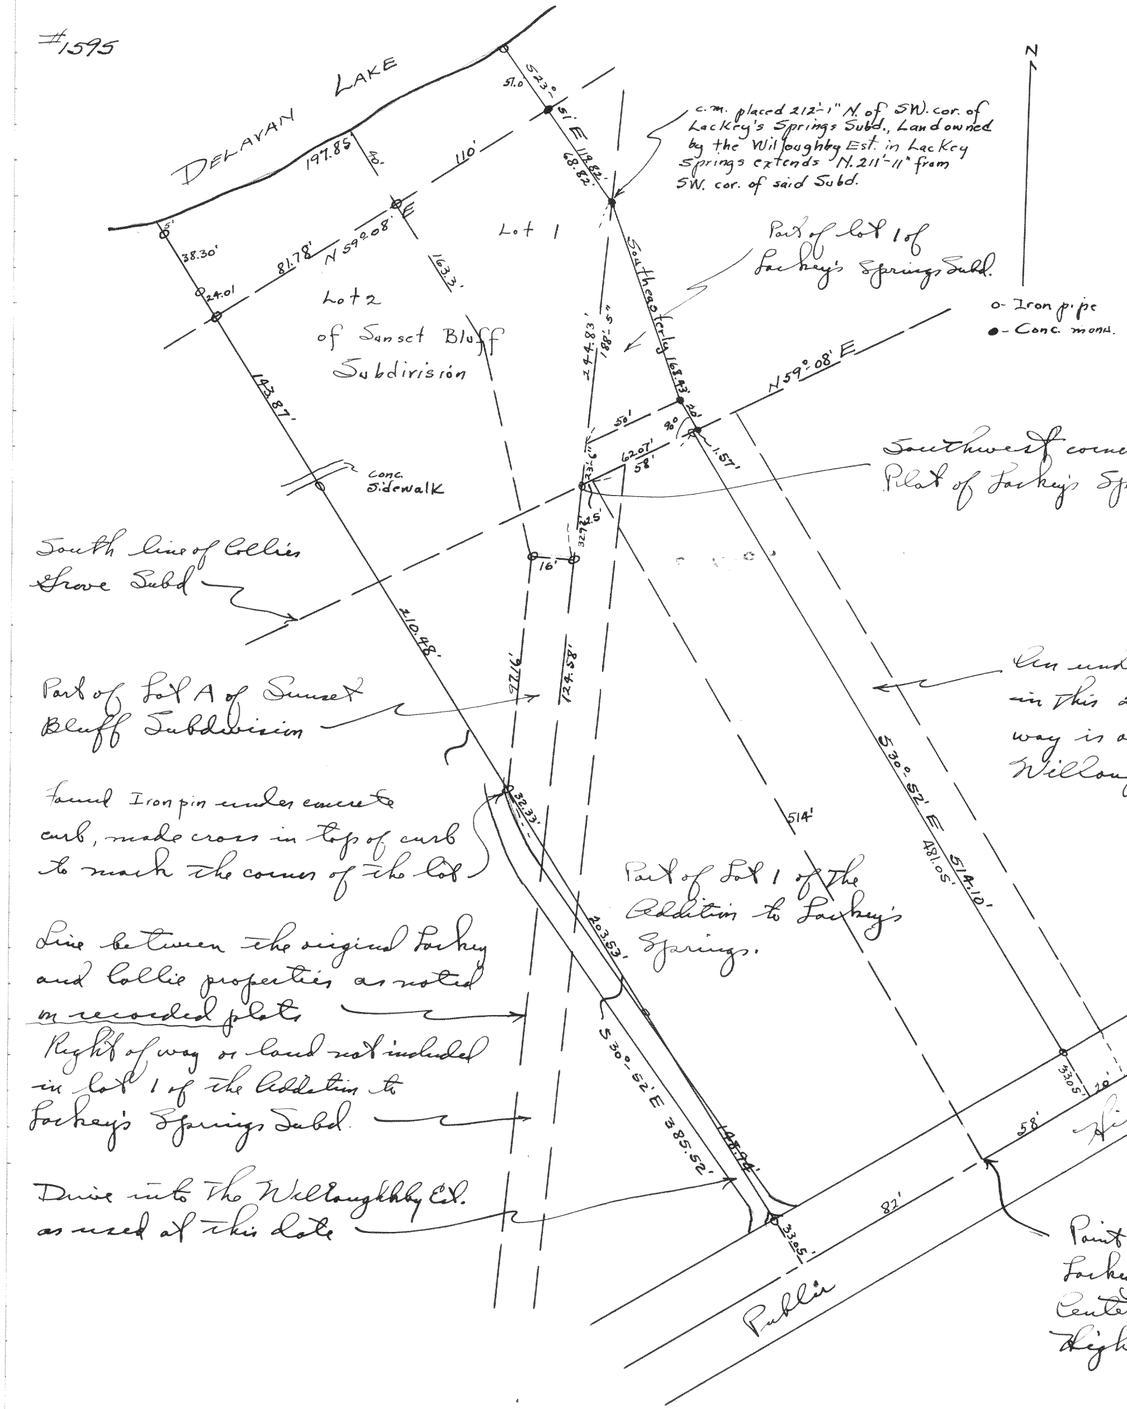

Plat of survey of the Willoughby Estate, located in the Northwest 1/4 of fractional Section 33, T2N R16E of Walworth County, Wisconsin.
8-3-45

Lloyd S. Jensen
County Surveyor

Point 320' from intersection of the Lackey - Collis line and the Centerline of the Public Highway.