SURVEY NO. 1223

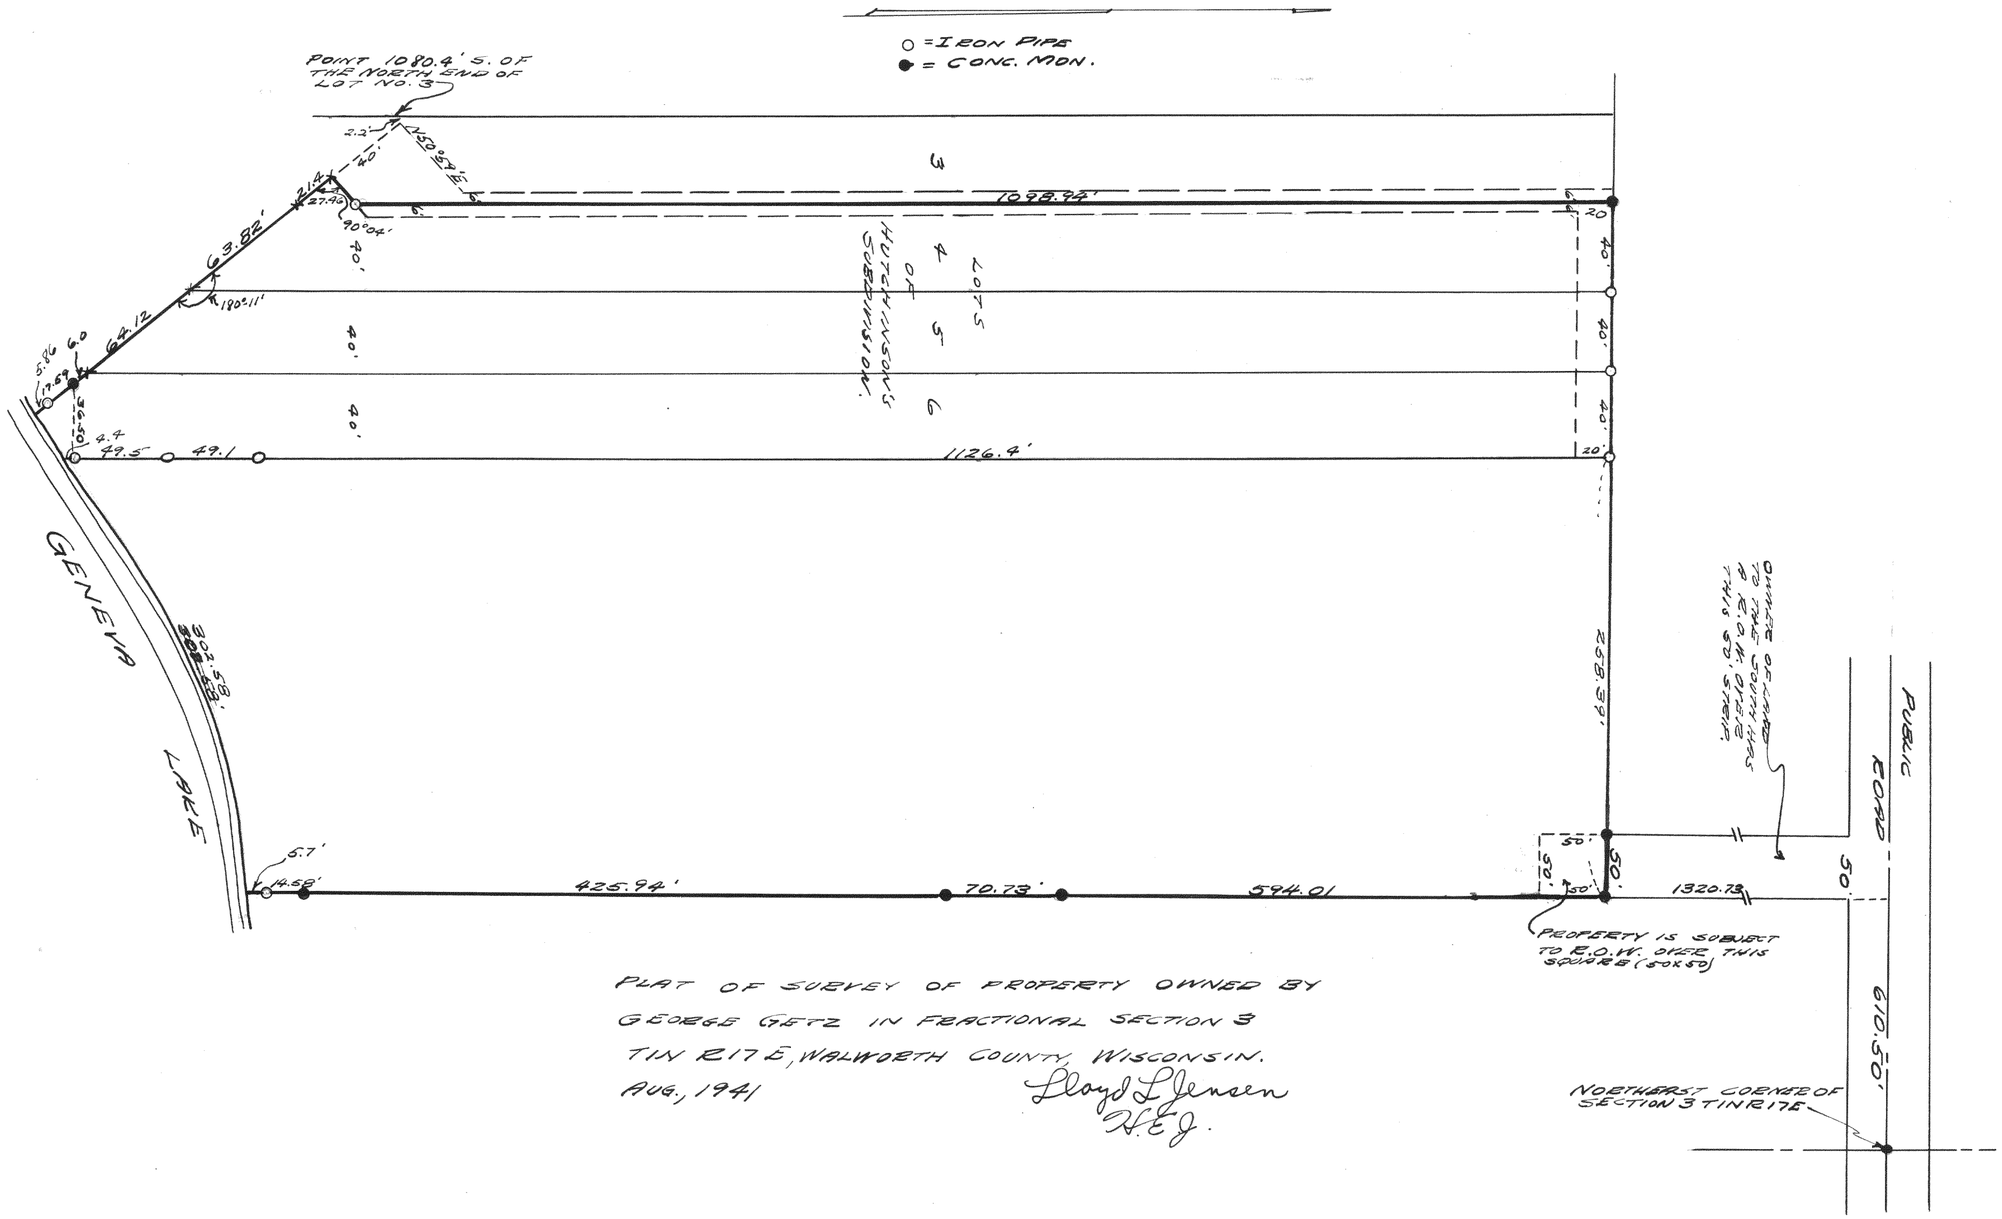

PLAT OF SURVEY OF PROPERTY OWNED BY
GEORGE GETZ IN FRACTIONAL SECTION 3
T1N R17E, WALWORTH COUNTY, WISCONSIN.
AUG., 1941

Lloyd L Jensen
W.E.J.