
#1598

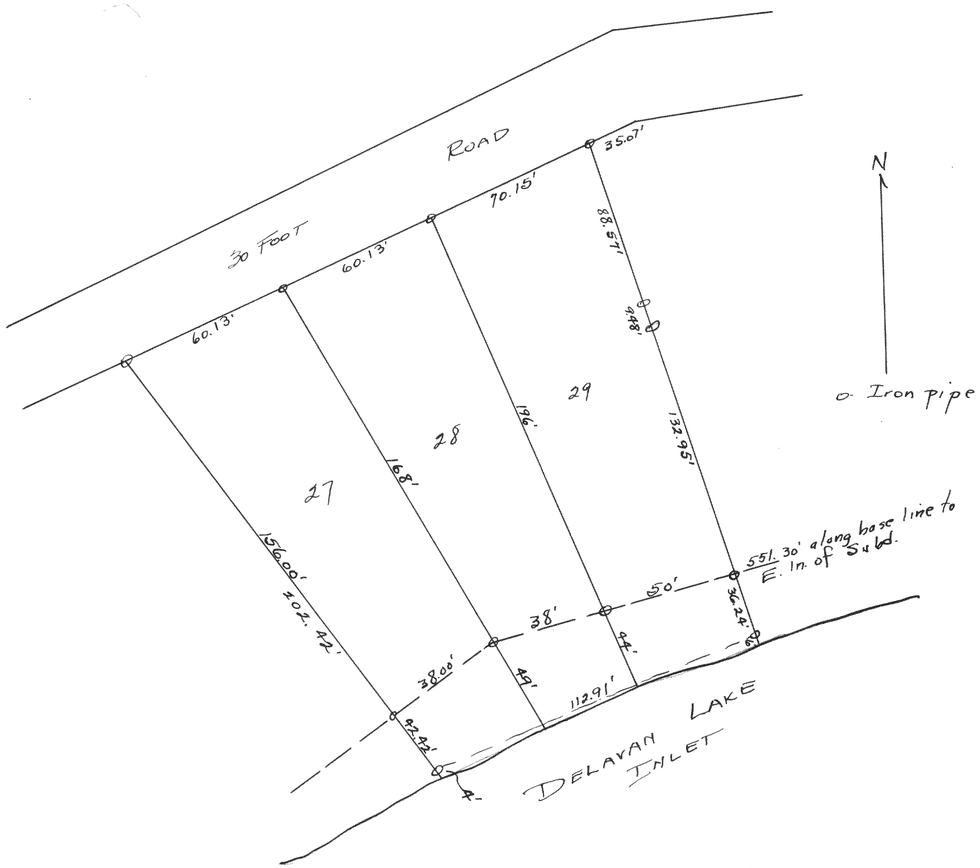


Plat of survey of lots 27-29 of the Annex to Lake Oaks, a subd located in Sections 15 and 22 of T22NR16E

Nov. 8, 1945

Lloyd L. Jensen
County Surveyor

#1599

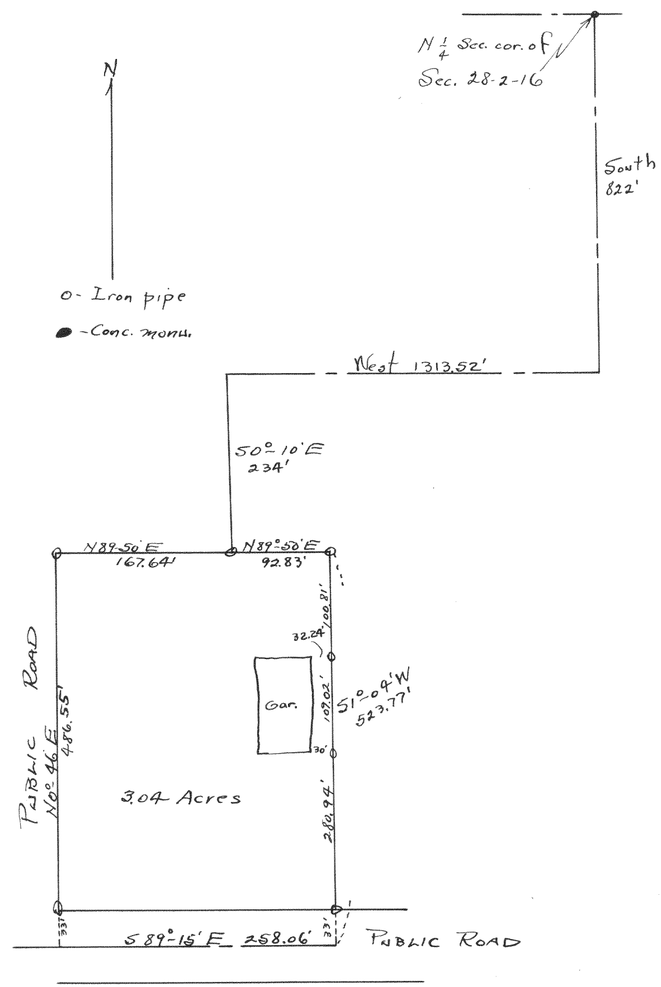

Plat of survey of a Gauge lot for Johannesson Farms in Section 28-2-16.

Dec. 1945

Lloyd L. Jensen
County Surveyor