
#1603

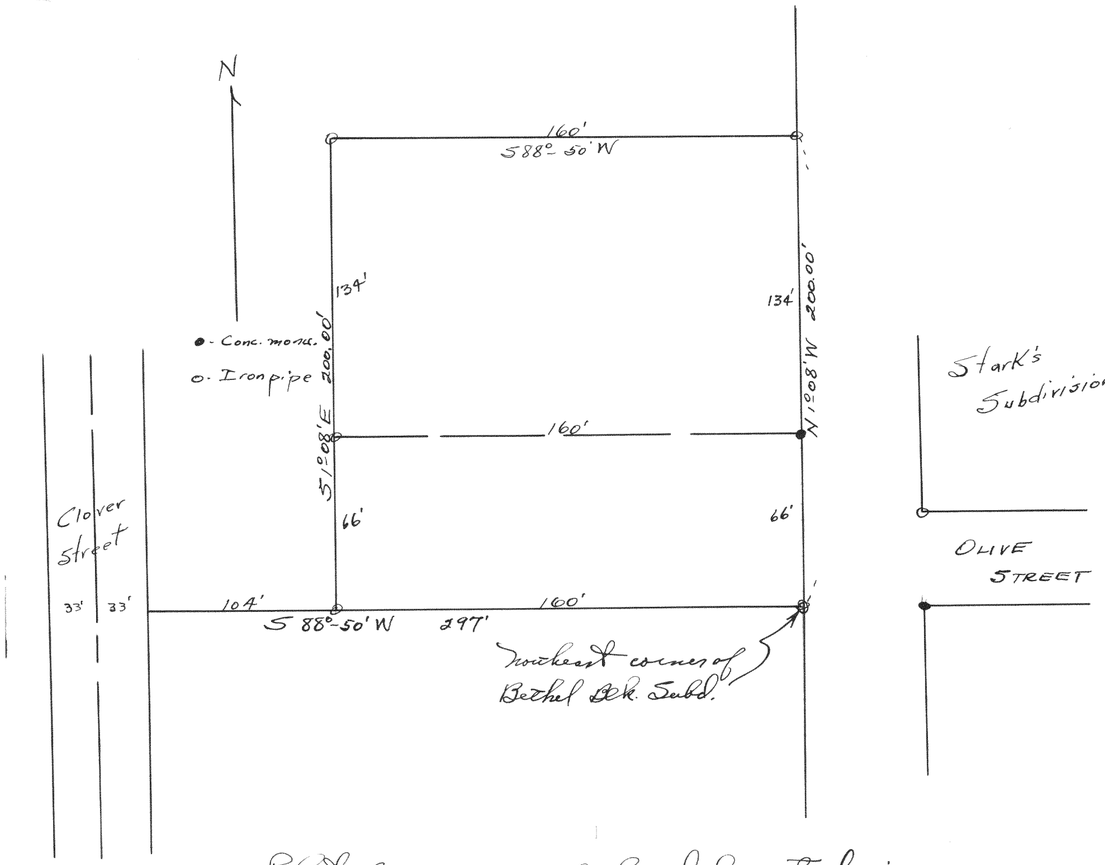


Plat of a survey of land located in The NE 1/4 of Section 1, T1N R16E, Village of Williams Bay Wisconsin.

Floyd S. Jensen
County Surveyor

Feb. 19, 1946

#1604

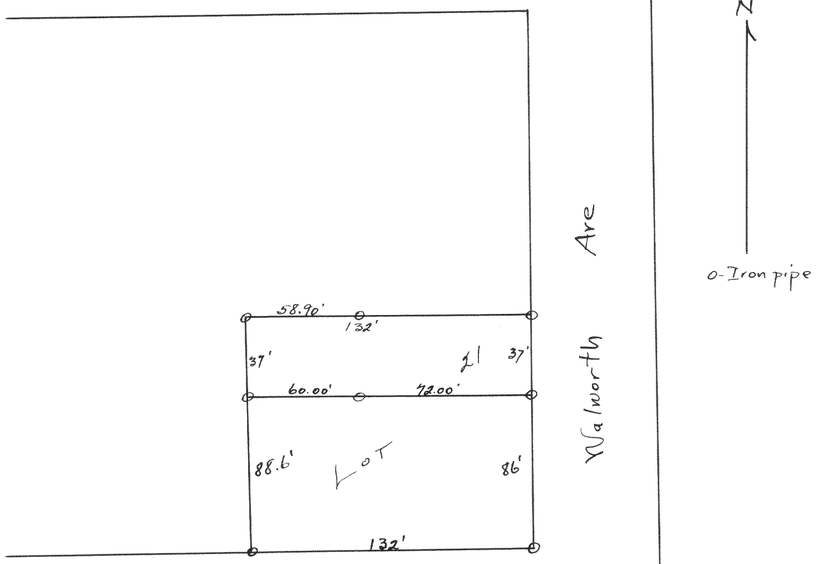

Plat of survey of Lot 21 of Johnson's Addition to The Village of Williams Bay, Wisconsin.

Floyd S. Jensen
County Surveyor

Feb. 20, 1946