
#1605

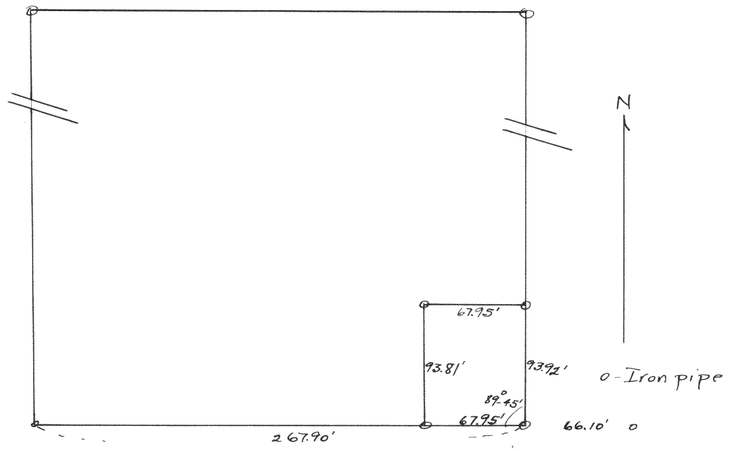



Floyd L. Jensen
County Surveyor

Oct. 1945

#1606

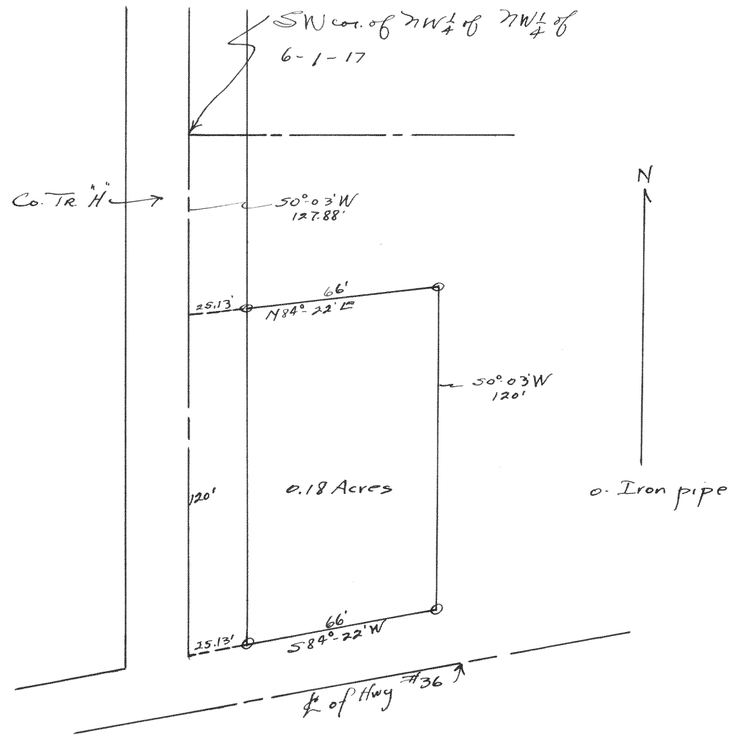

Plat of a survey of a parcel of land located in the NW¼ of Section 6-1-17 - Village of Williams Bay Wisconsin.

Floyd L. Jensen
County Surveyor

Nov. 1945