
#1607

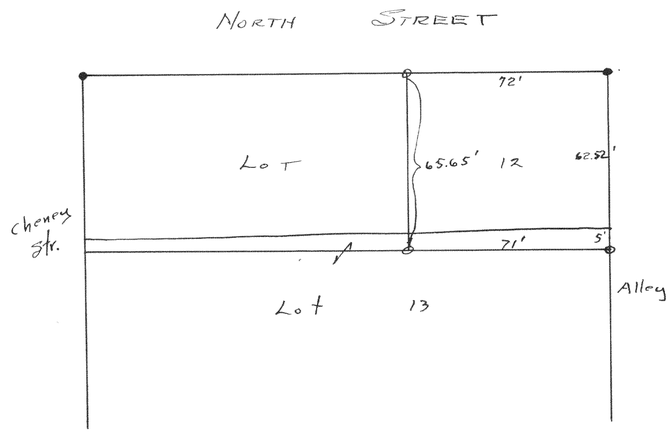


Plat of survey of part of lots 12 and 13 of Blk 2 of Tuppi's 2nd Add. to the City of Whitewater.

Oct. 24, 1945

Lloyd L. Jensen
County Surveyor

#1608

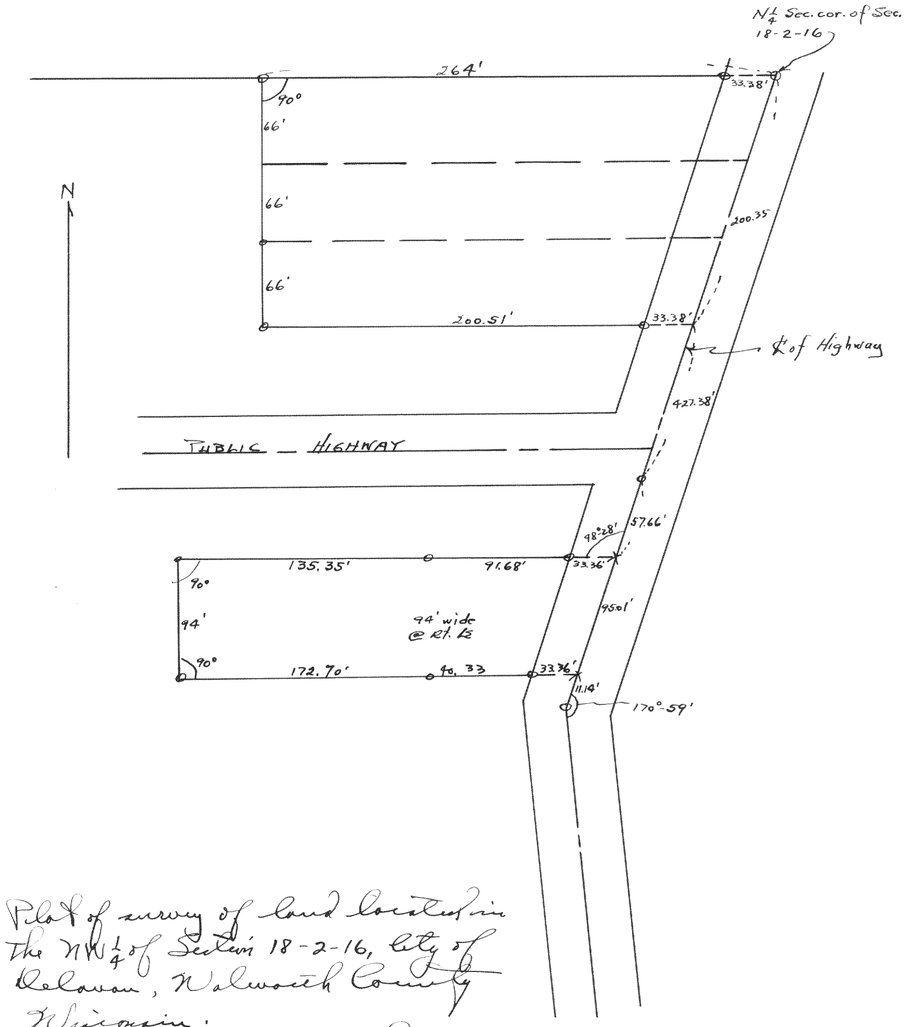

Plat of survey of land located in the NW¼ of Section 18-2-16, City of Delavan, Walworth County Wisconsin.

May 1945

Lloyd L. Jensen
County Surveyor