
226

1609

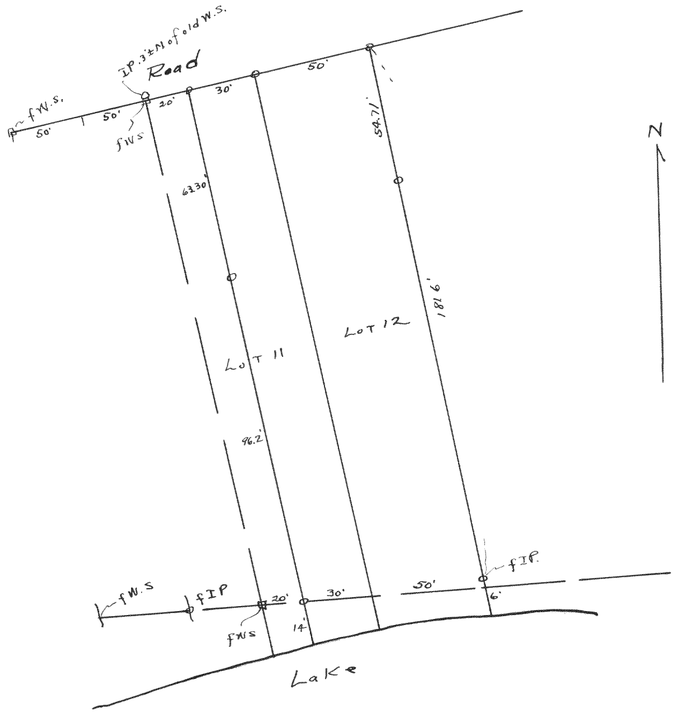


Plat of survey of Lot 12 and the E. 30' of Lot 11 of the 1st Add. to Sunderdale Park.

Floyd S. Jensen
County Surveyor

June 1945

1610

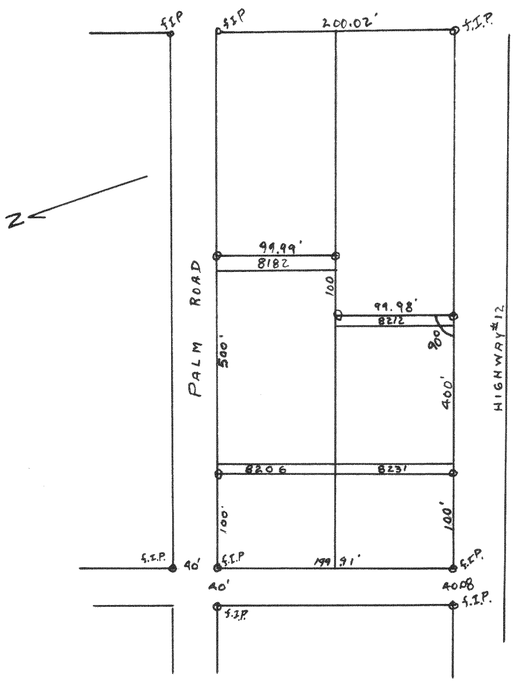

Plat of Survey of Lots 8182 to 8206 and Lots 8212 to 8231 in Section 5 of Bell Lake Subdivisions Walworth County, Wisc.

Oct. 1946

Floyd Jensen
County Surveyor
G.T.D