
#1613

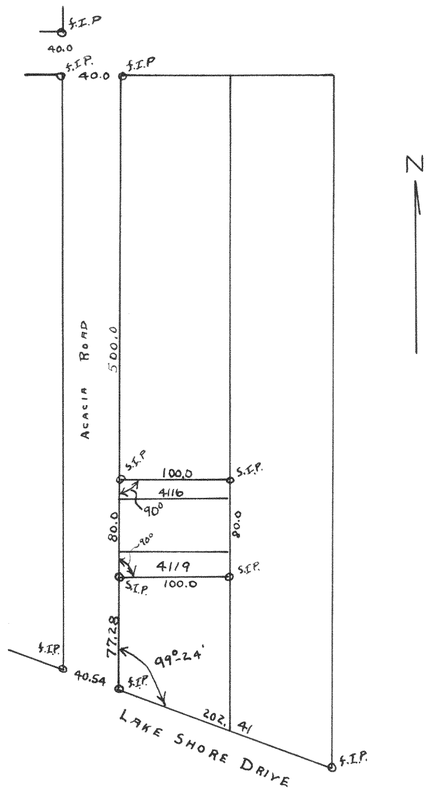


Plat of Survey of Lots 4116 to 4119 of Lake Como Beach Subdivision, Walworth County, Wisconsin

Aug. 1946

Lloyd I Jensen
County Surveyor
G.T.D

#1614

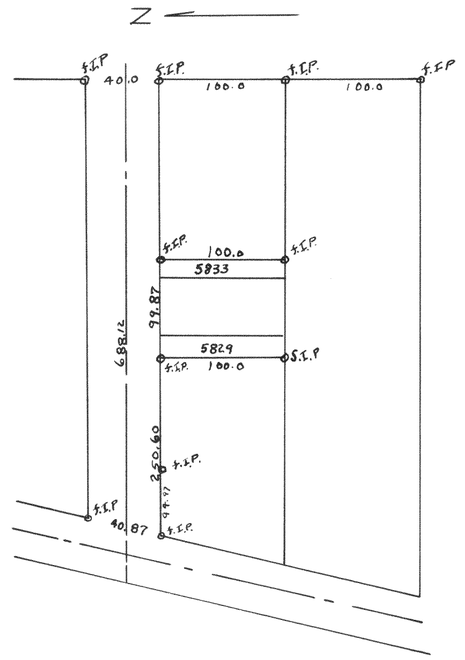

Plat of Survey of Lots 5829 to 5833 in Section 4 of Bell Lake Subdivision Walworth County, Wisconsin

Aug 1946

Lloyd I Jensen
County Surveyor
G.T.D