
#1615

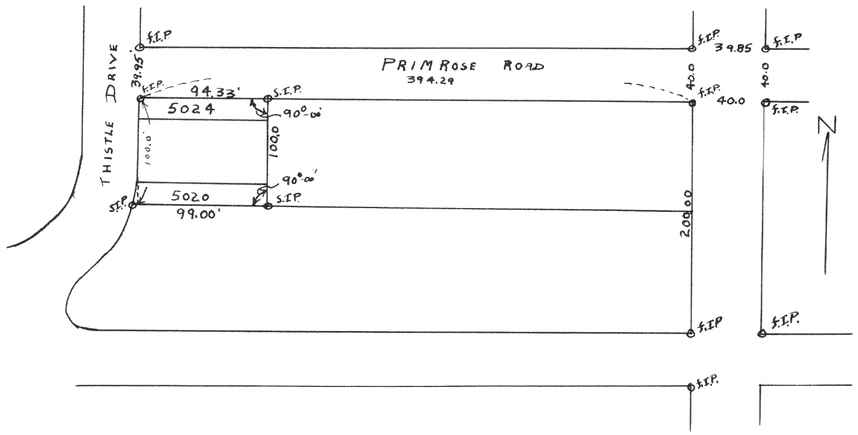


Plat of Survey of Lots 5020 to 5024 in Section 3
of Bell Lake Subdivisions, Walworth County, Wisconsin

Aug. 1946

Lloyd L. Jensen
County Surveyor
G.T.D

#1616

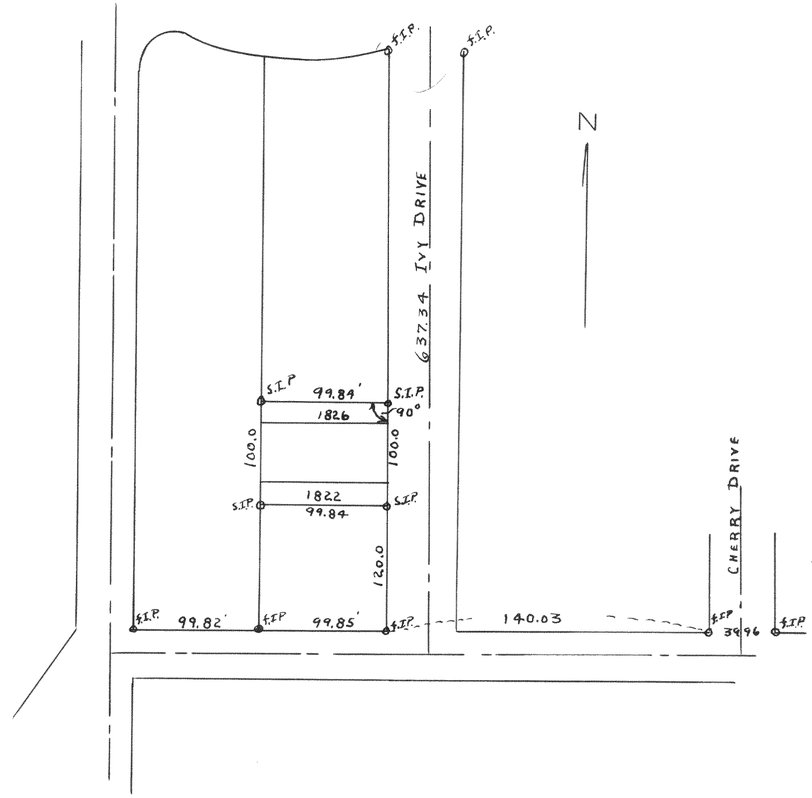

Plat of Survey of Lots 1822 to 1826 in Section I
of Bell Lake Subdivisions in Walworth County, Wisc.

Aug. 1946

Lloyd L. Jensen
County Surveyor