

SURVEY No. 1224

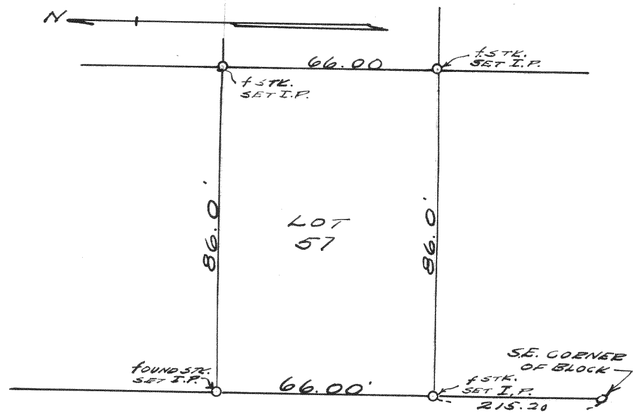

PLAT OF SURVEY OF ROBINSON'S SECOND SUBDIVISION, (LOT 57). T1N R17E, WALWORTH COUNTY, WISCONSIN
MAY, 1941

Lloyd L Jensen
R.E.S.

SURVEY No. 1225

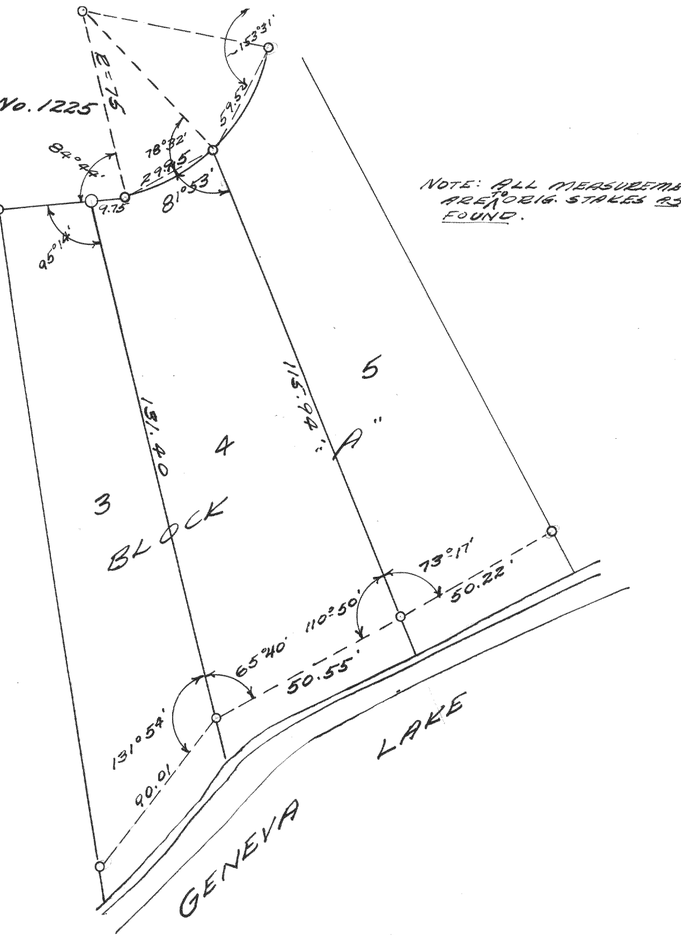

NOTE: ALL MEASUREMENTS ARE TO BIG STAKES AS FOUND.

SURVEY OF LOT 4 BLOCK "A" OF CISCO BEACH SUBD., SECTION 5, T1N R17E, WALWORTH CO., WISC.
JUNE 1941

Lloyd L Jensen
R.E.S.