
#1617

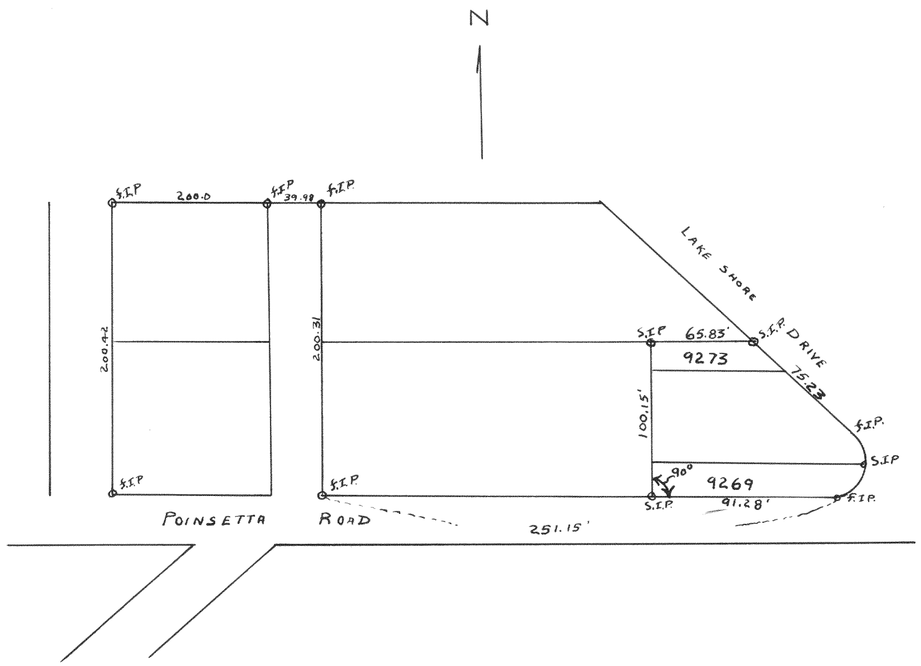


Plat of Survey of Lots 9269 to 9273 in Section 5 of Pell Lake Subdivisions, Walworth County, Wisconsin

Sept 1946

Lloyd L. Jensen
County Surveyor

#1618

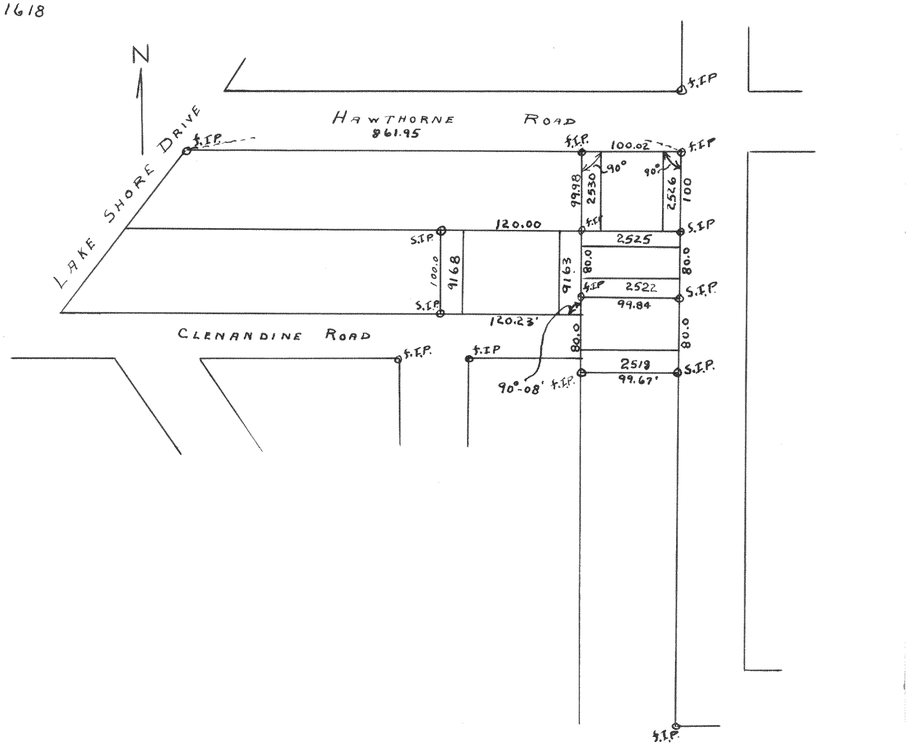

Plat of Survey of Lots 2518 to 2530 in Section 2 and Lots 9163 to 9168 in Section 5 of Pell Lake Subdivisions, Walworth County, Wisconsin

Sept. 1946

Lloyd L. Jensen
County Surveyor