
#1621

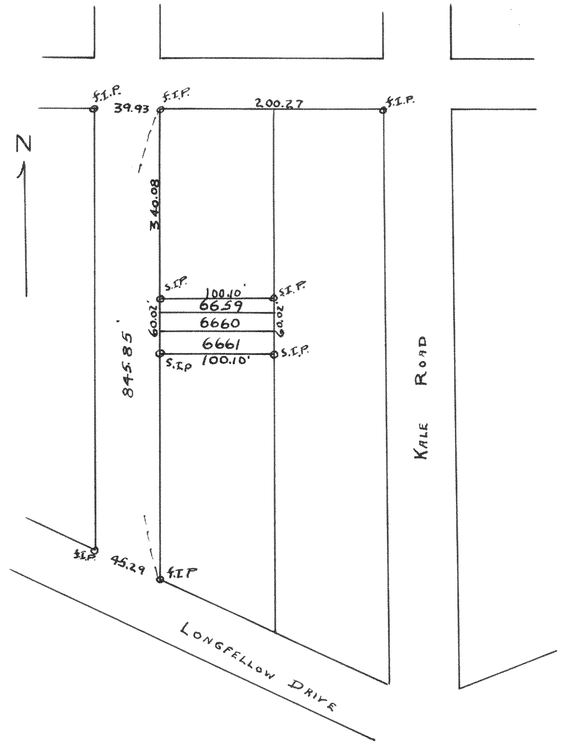


Plat of Survey of Lots 6659 to 6661 in Lake Como Beach Subdivision Walworth County, Wisconsin

Sept. 1946

Lloyd I. Jenson
County Surveyor
G.T.D

#1622

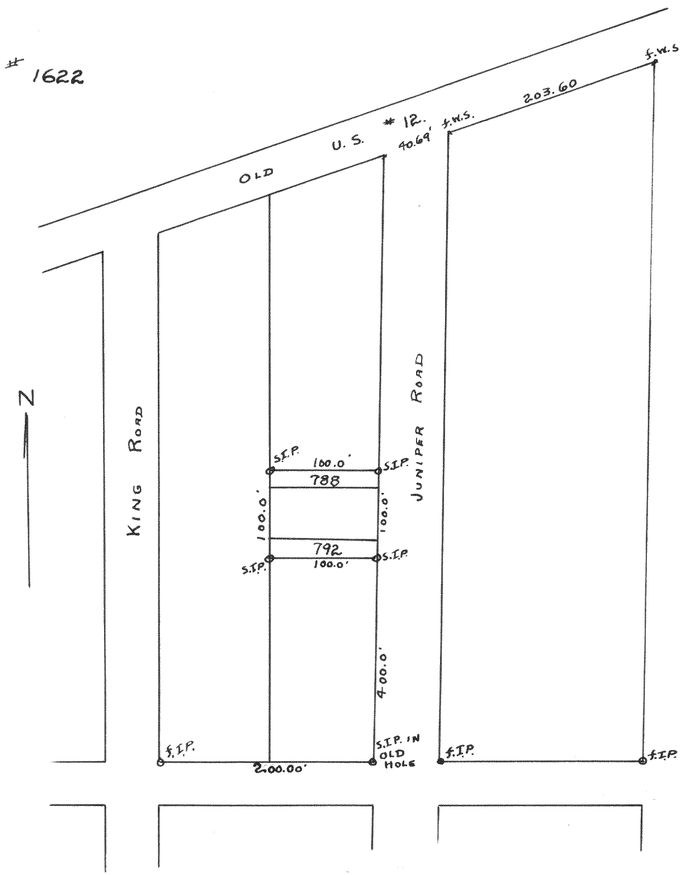

Plat of Survey of Lots 788 to 792 of Lake Como Beach Subdivisions in Walworth County, Wisconsin

Sept. 1946

Lloyd I. Jensen
County Surveyor
G.T.D.