
1623

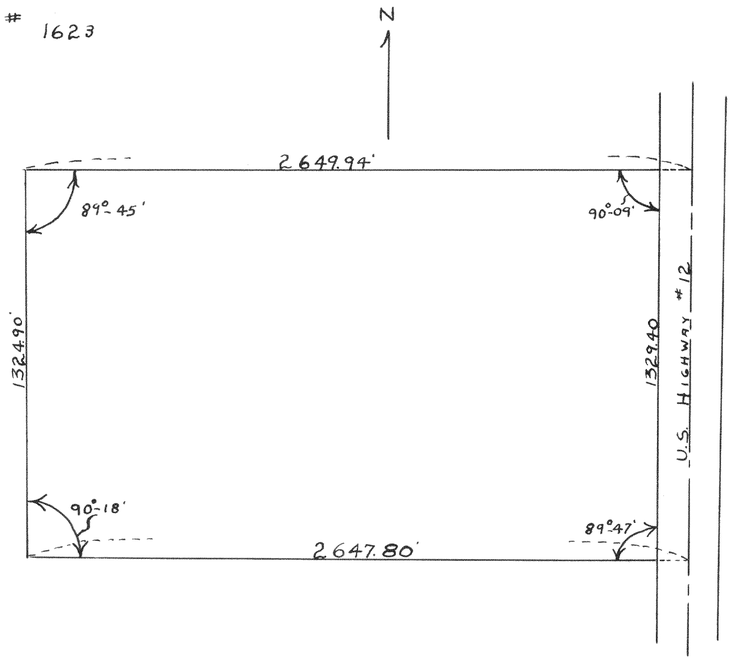


Plat of 7 more Line Survey of the Ben Cameron
7 acres located in the S.1/2 of the NE 1/4 of Section 7
T2N R17E, Walworth County Wisconsin

Lloyd L. Jensen
County Surveyor
G.T.D.

Sept 1946

1624

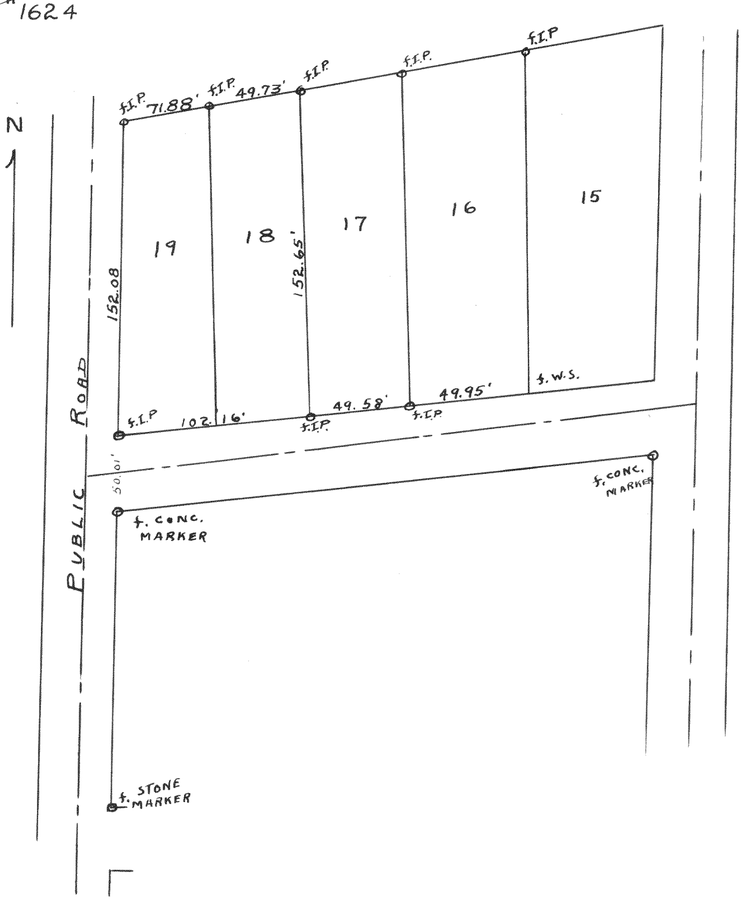

Plat of Survey of Lots 18 and 19, Elliotts Subdivision,
Powers Lake, Walworth County, Wisconsin

Lloyd L Jensen
County Surveyor
G.T.D.

Oct 1946