
1627

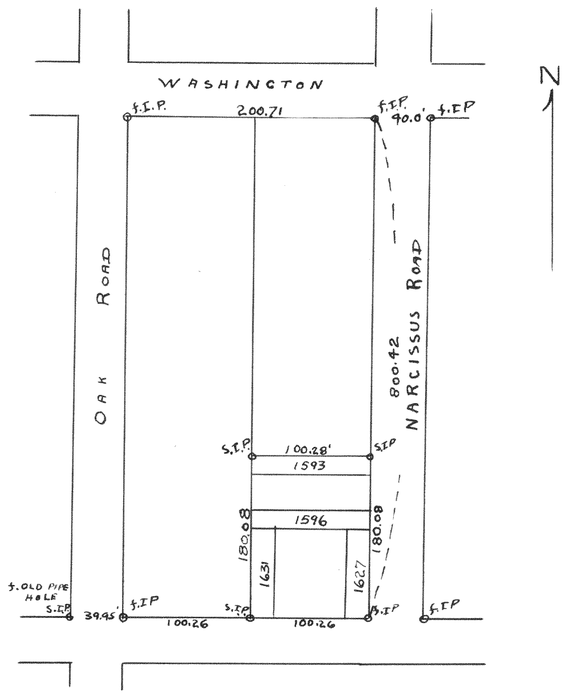


Plat of Survey of Lots 1593 to 1596 and Lots 1627 to 1631 in Lake Como Beach Subdivision Walworth County Wisconsin

Oct. 1946

Lloyd L Jensen
County Surveyor
G.T.D

1628

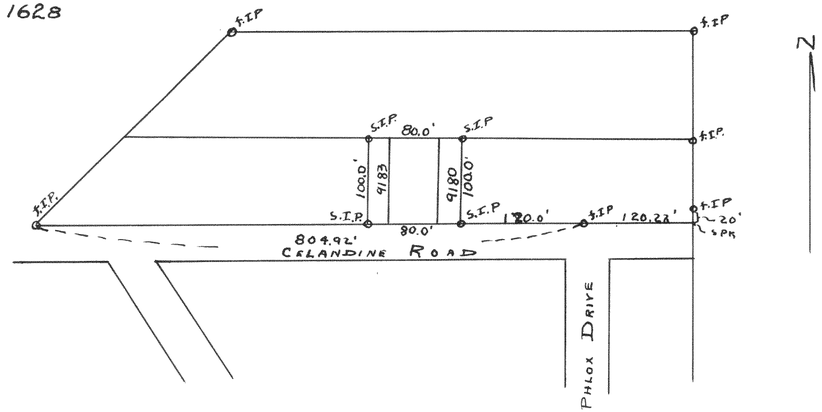

Plat of Survey of Lots 9180 to 9183 in Section 5 of Bell Lake Subdivision, Walworth County Wisconsin

Oct. 1946

Lloyd L Jensen
County Surveyor
G.T.D