
#1635

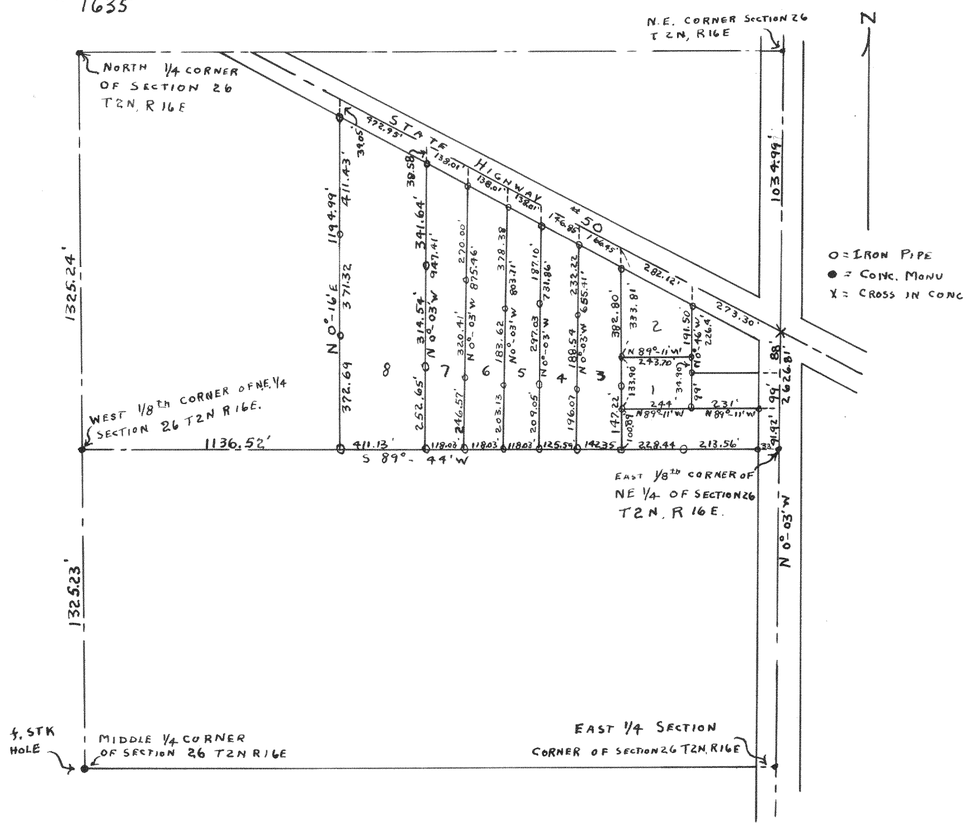


Plat of Survey of Parcels of land 1 to 8 on the Wickstrom Farm located in the NE 1/4 of Section 26 T2N, R16E Walworth County Wisconsin

Oct 1946

Lloyd L Jensen
County Surveyor
G.T.D

#1636

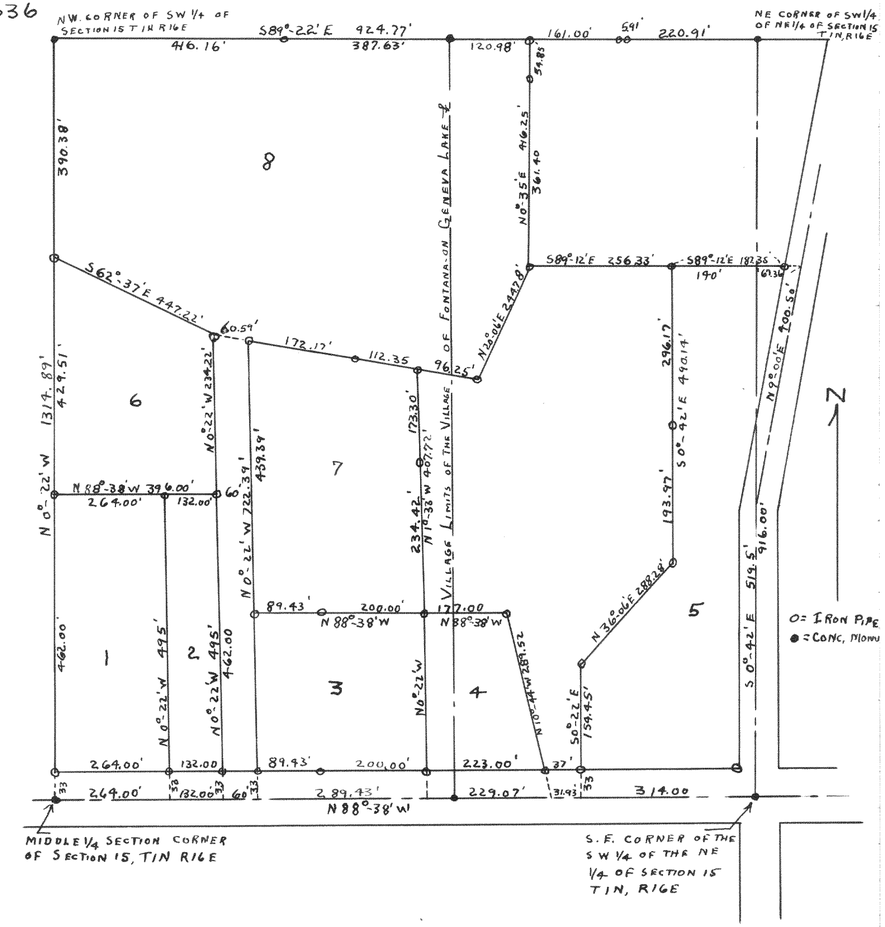

Plat of Survey of land located in the SW1/4 of the NE 1/4 of Section 15 T1N R16E part of which is known as Outlot 18 of Assessors Plat No. 1, C.L. Douglass Addition to the Village of Fontana-on-Geneva Lake Walworth County Wisconsin

Feb. 47

Lloyd L. Jensen
County Surveyor
G.T.D.